

2784

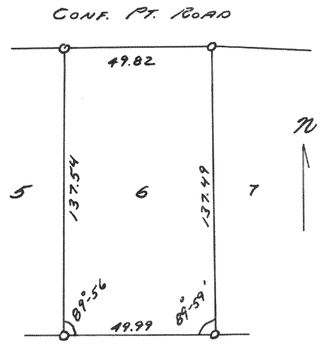


Plat of Survey of Lot 6
of Summershaven Village of
Williams Bay July 1953
LLJ
CS

2785

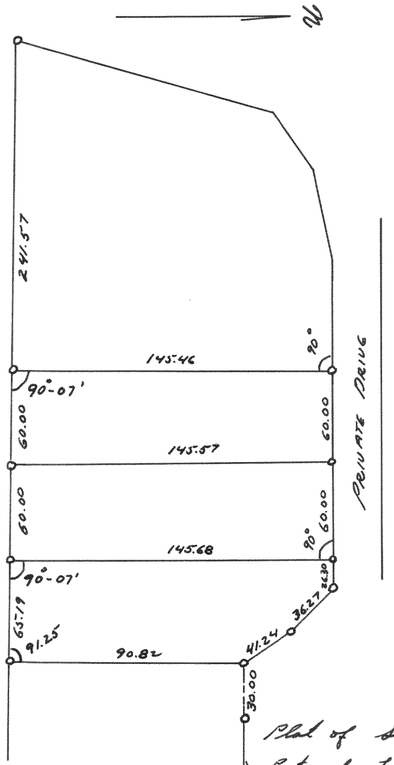

Plat of Survey of
Part of Lot 15 of
Jewell's Sub.
Village of Williams Bay
July 1953
LLJ
CS


2786

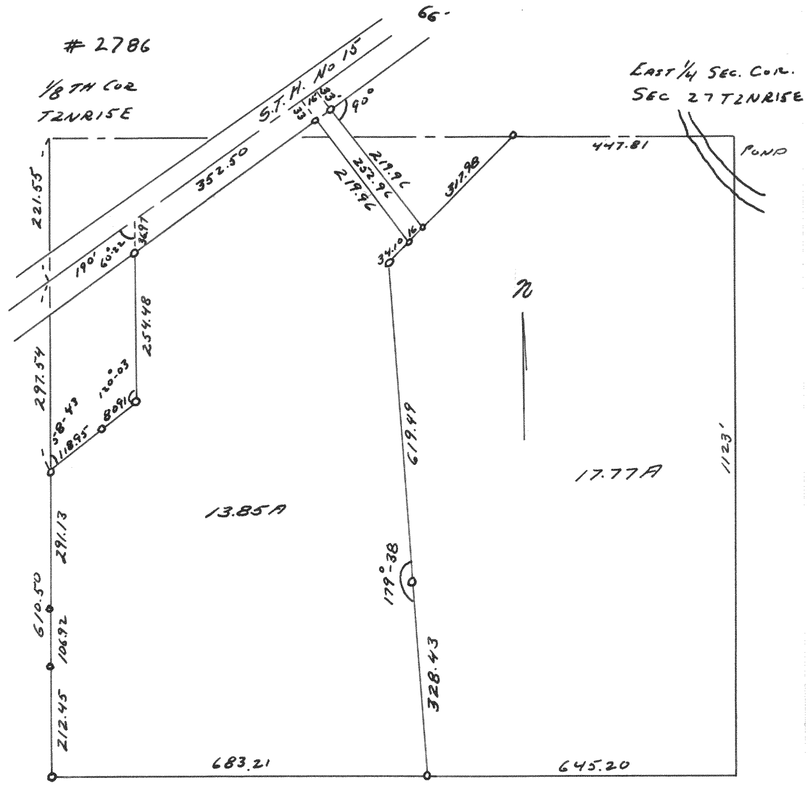


Plat of Survey of Land Located in East 1/2
of Section 27 T2N R15E
April 1953
LLJ
CS

2787

Plat of Survey of Lots 5-8 in
2nd Observatory Sub. Village of Wms Bay
AUG. 1953 LLJ CS

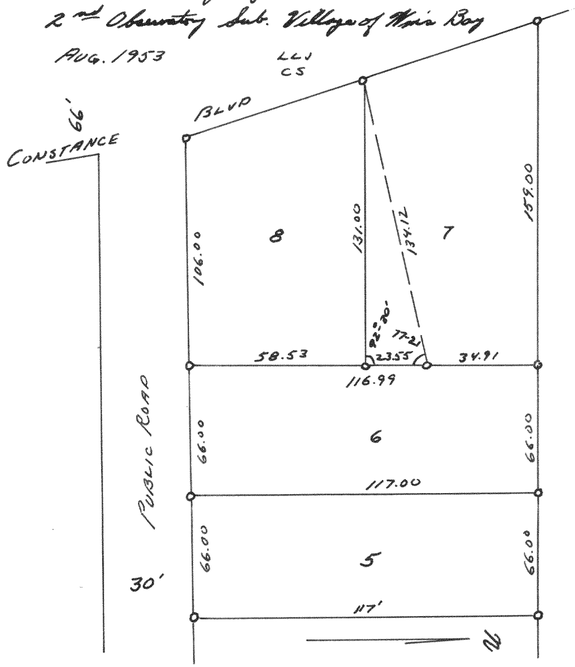

2788

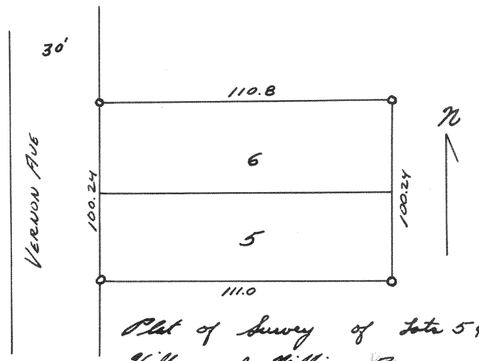

Plat of Survey of Lots 5 & 6 of Lockwood Subdivision
Village of Williams Bay
Aug. 1953
LLJ
CS