
4185

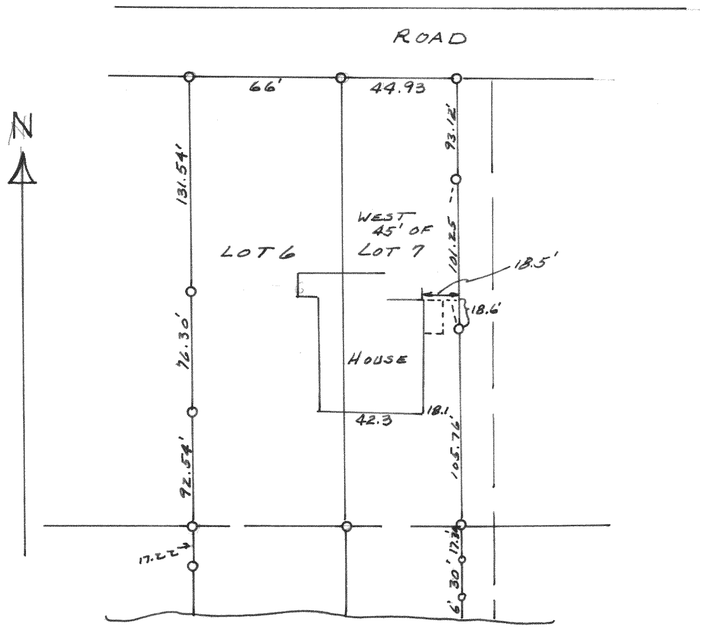


PLAT of Lot 6 & West 45' of Lot 7 of Cedar Point - Delavan Lake.

July 23, 1962

Floyd L. Jensen
Surveyor

4186

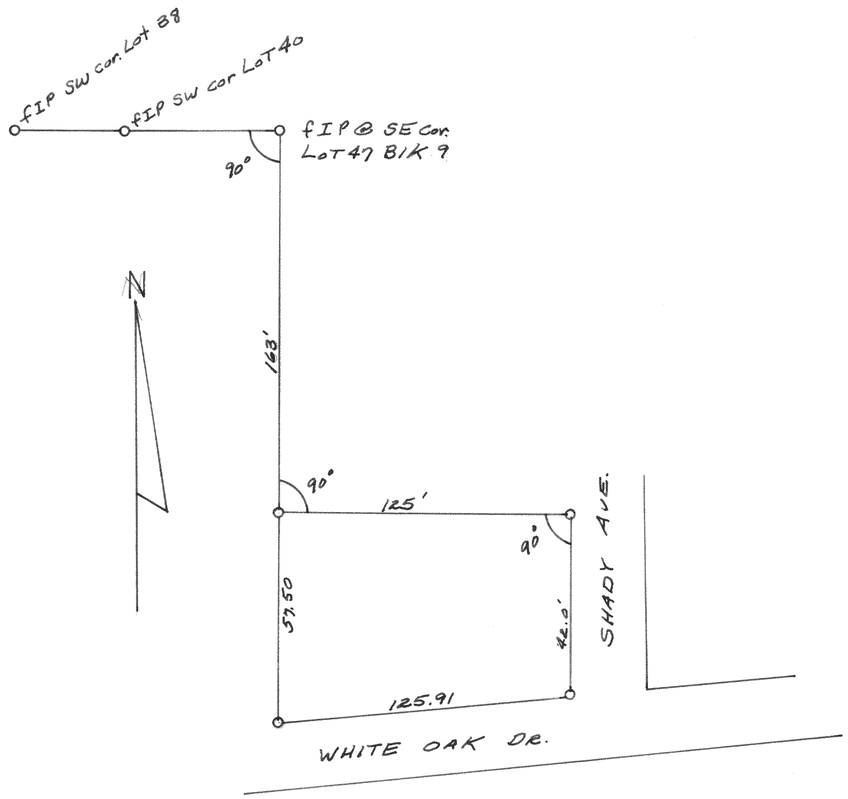

Survey of Lot 18 of Block 7 of Inlet Oaks Subd. No 4 in Delavan Town

July 1962

Floyd L. Jensen
Surveyor