#4187

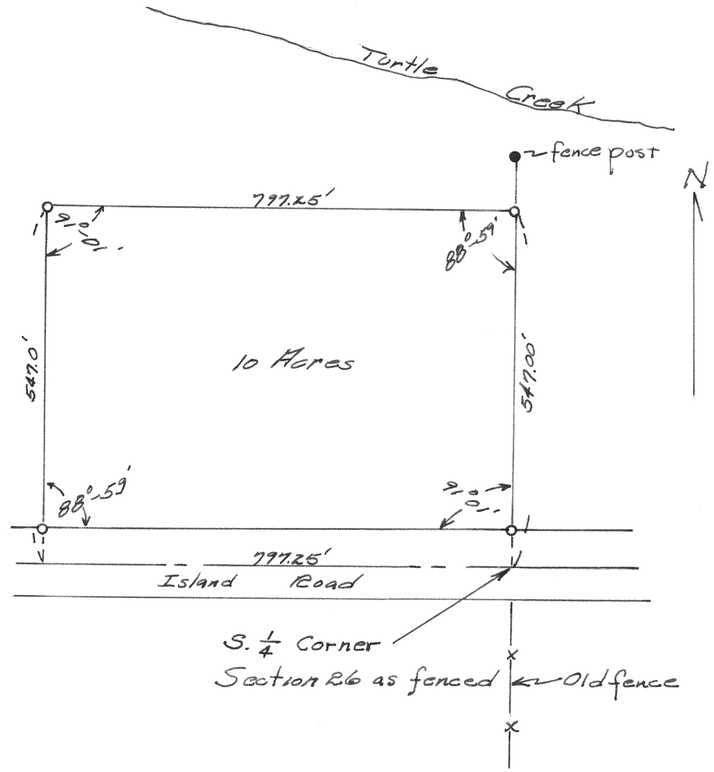

Plat of survey of land located in the Southwest 1/4 of Section 26, T3N R1E

Floyd L. Jensen

Sept. 1963
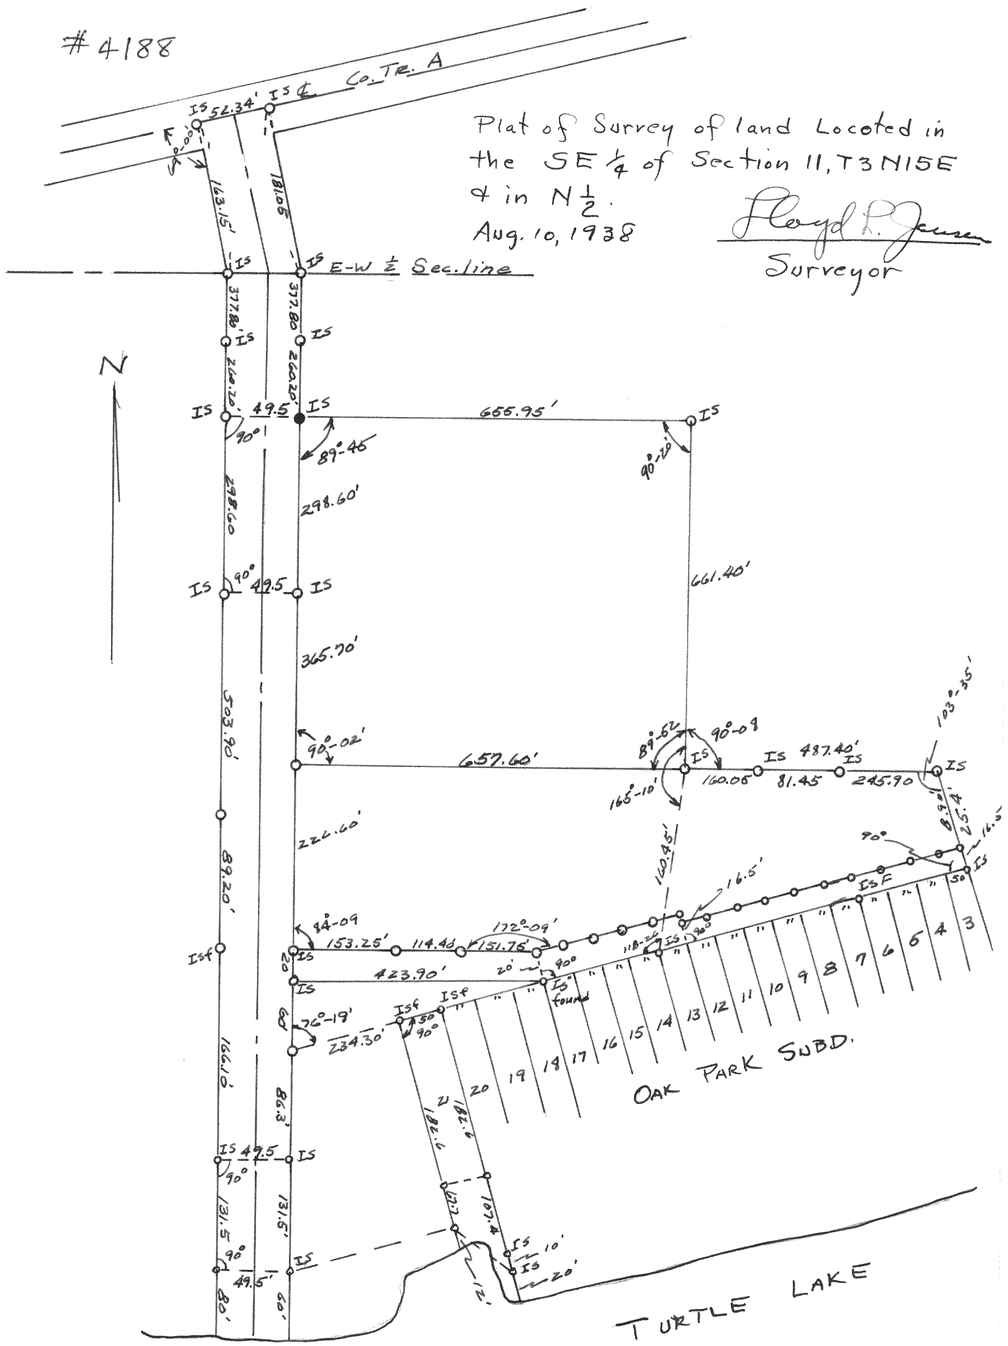
#4188