
#4187

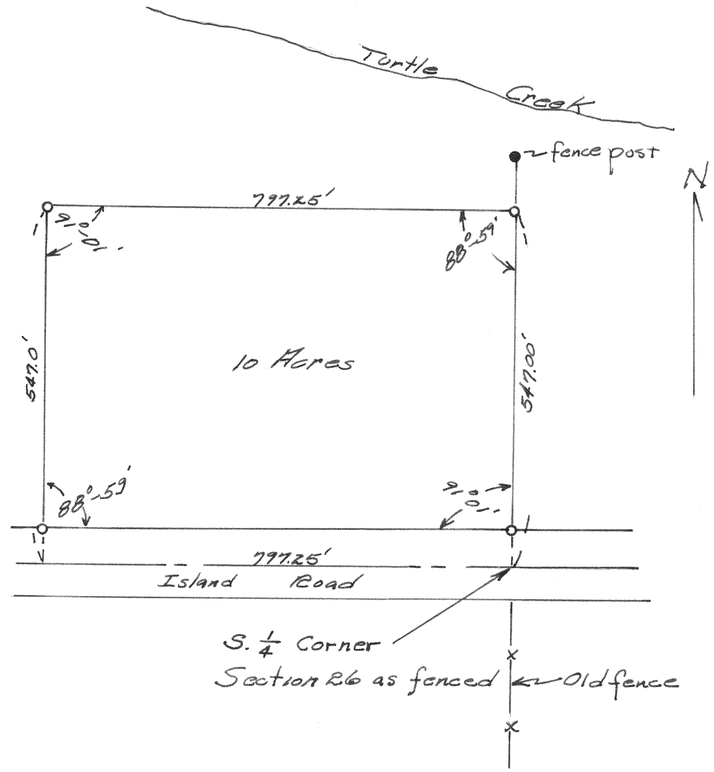


Plat of survey of land located in the Southwest 1/4 of Section 26, T3N R1E

Floyd P. Jensen

Sept. 1963

#4188

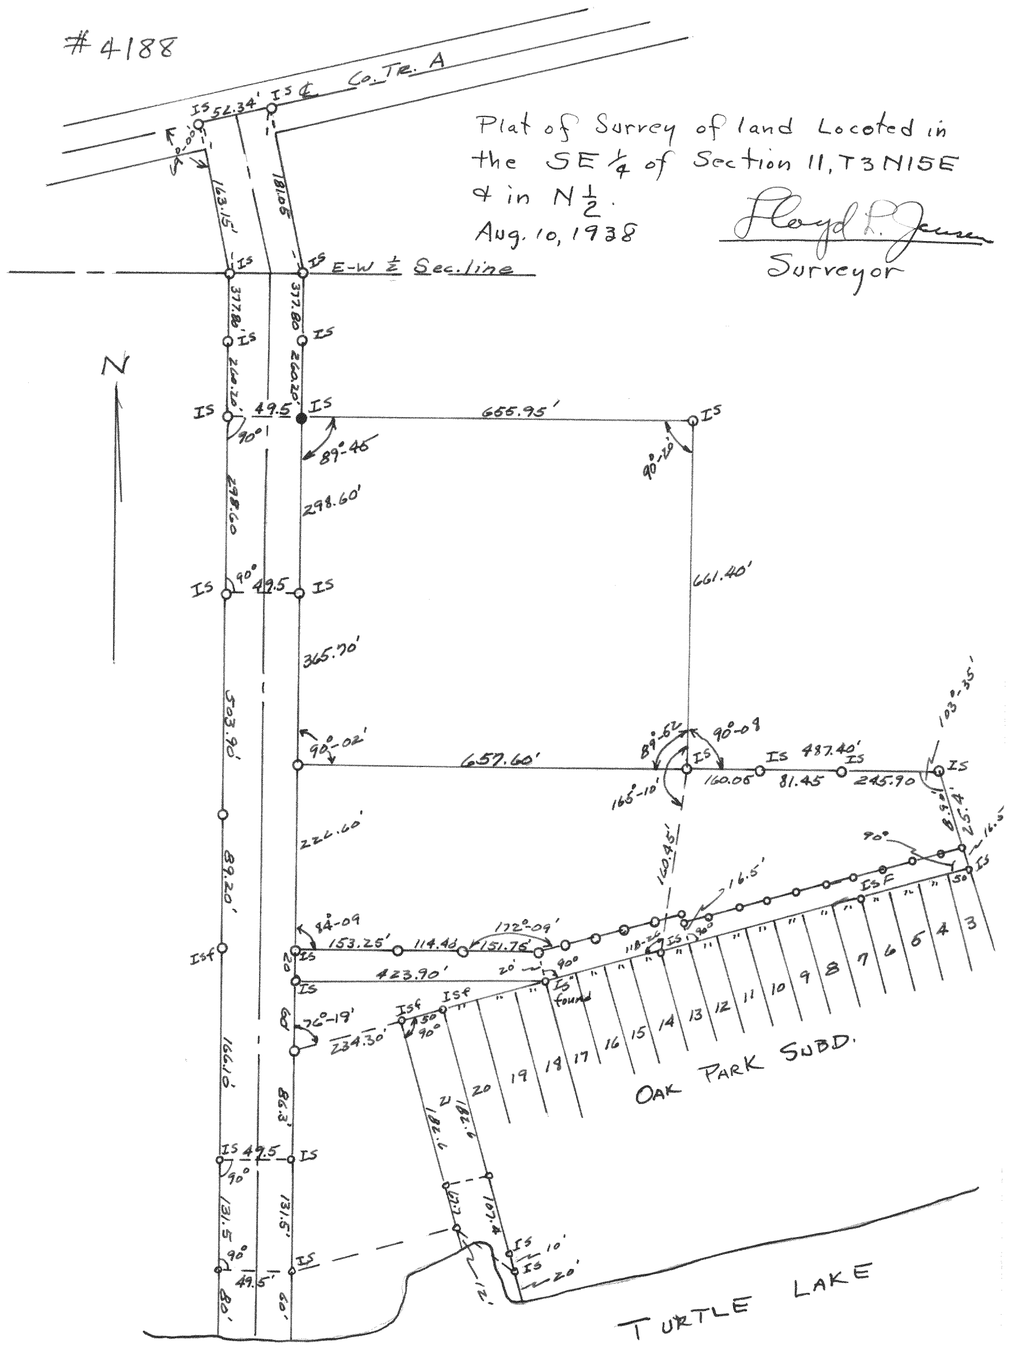
Co. Tr. A
IS 52.34'
IS ℄
F 8.00'
163.15'
181.05'
IS E-W ± Sec. line
377.80'
377.80'
IS
IS
IS