

#4195

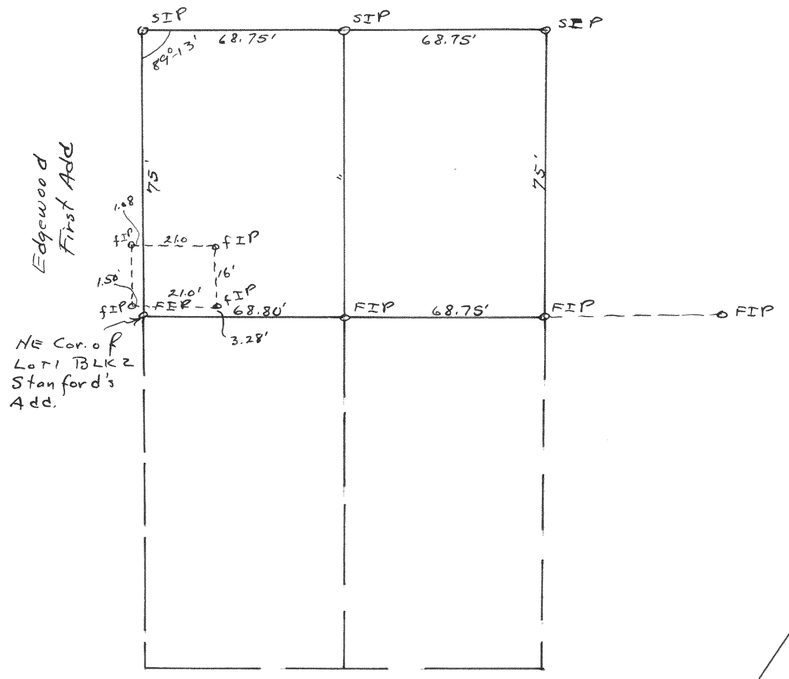

Survey of land located in the Northeast ¼ of Section 36, T3N R16E, City of Elkhorn
Nov. 1962
Floyd L. Jensen
Surveyor

#4196

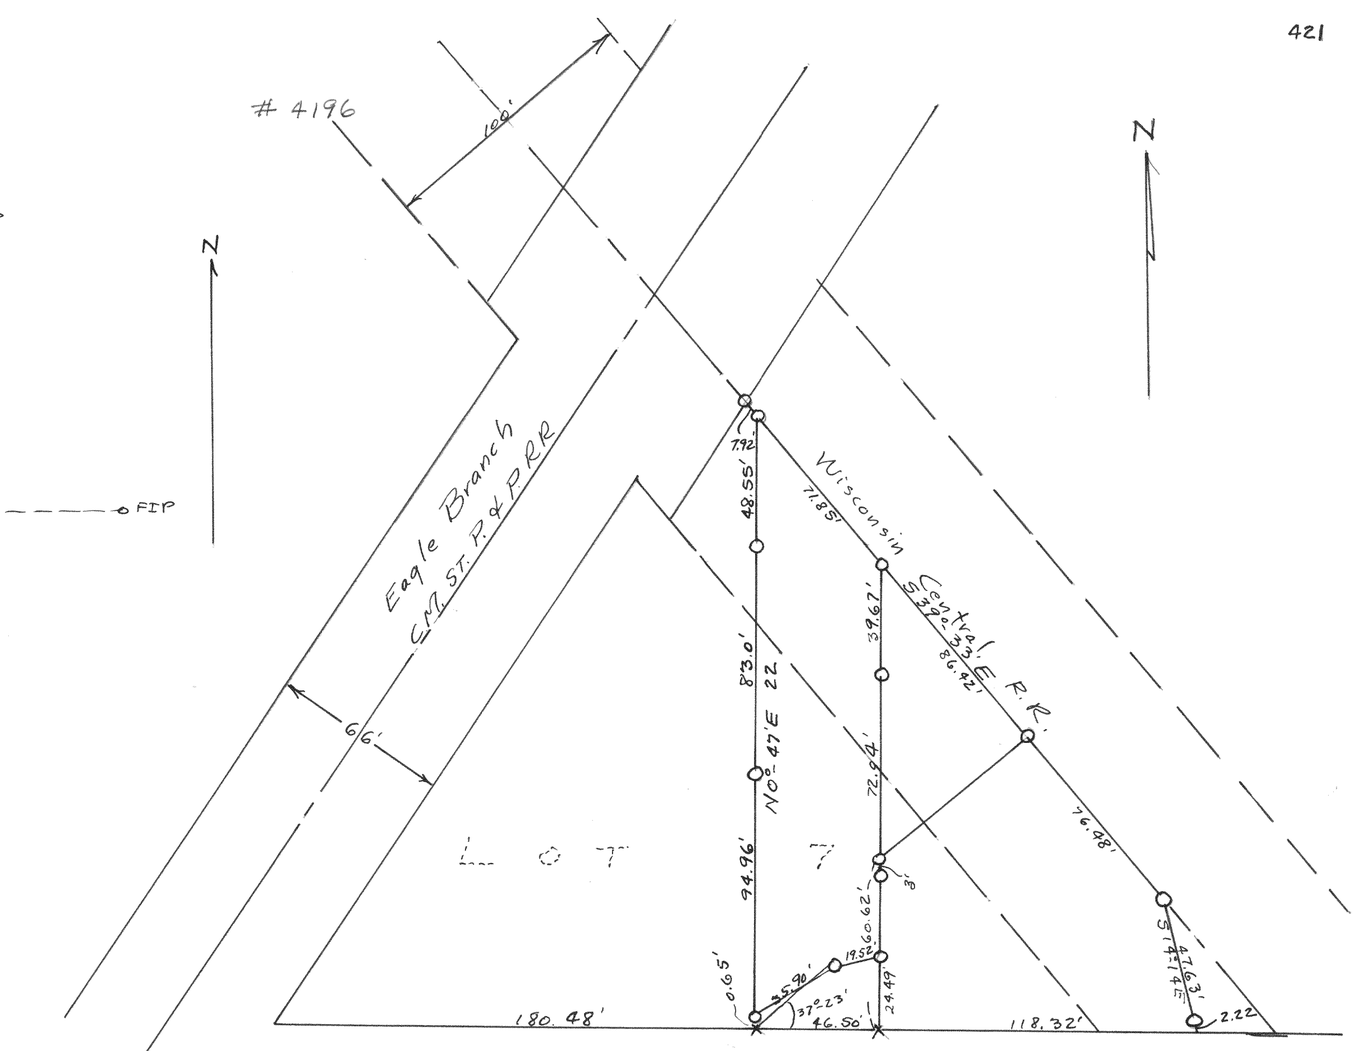

Plat of survey of part of Lot 7 Block 5 of Arnolds Add. to the City of Elkhorn and Railroad Right of way.
March 1951
Nov. 6, 1962
Floyd L. Jensen
Surveyor