
#4197

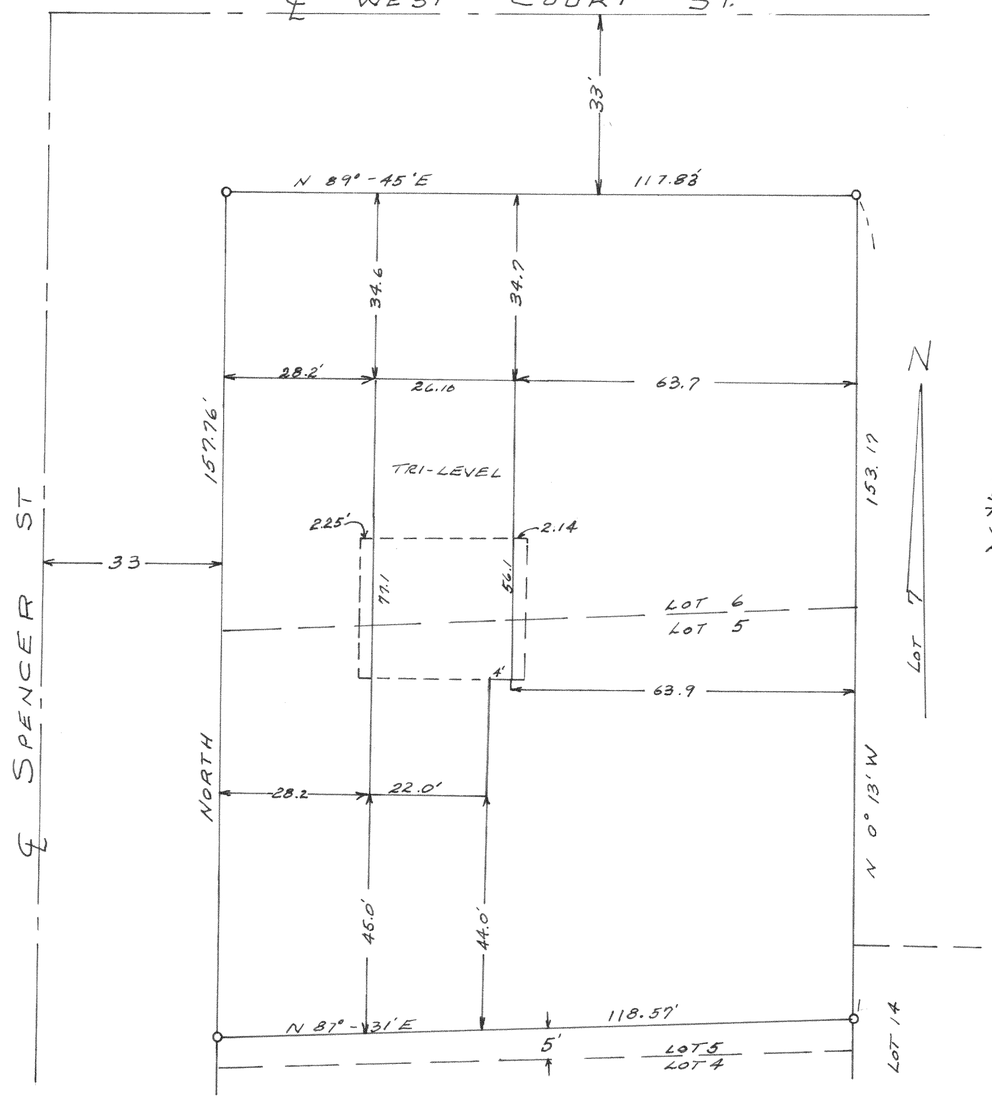

PLAT OF SURVEY OF

LOT 6 AND 5 (EXCEPT THE So. 5') OAKLAND SUBD. SEC. 36 T3N, RICE CITY OF ELKHORN WALWORTH COUNTY APRIL 1964

Floyd D. Jensen
CO. SURVEYOR