
424

#4199

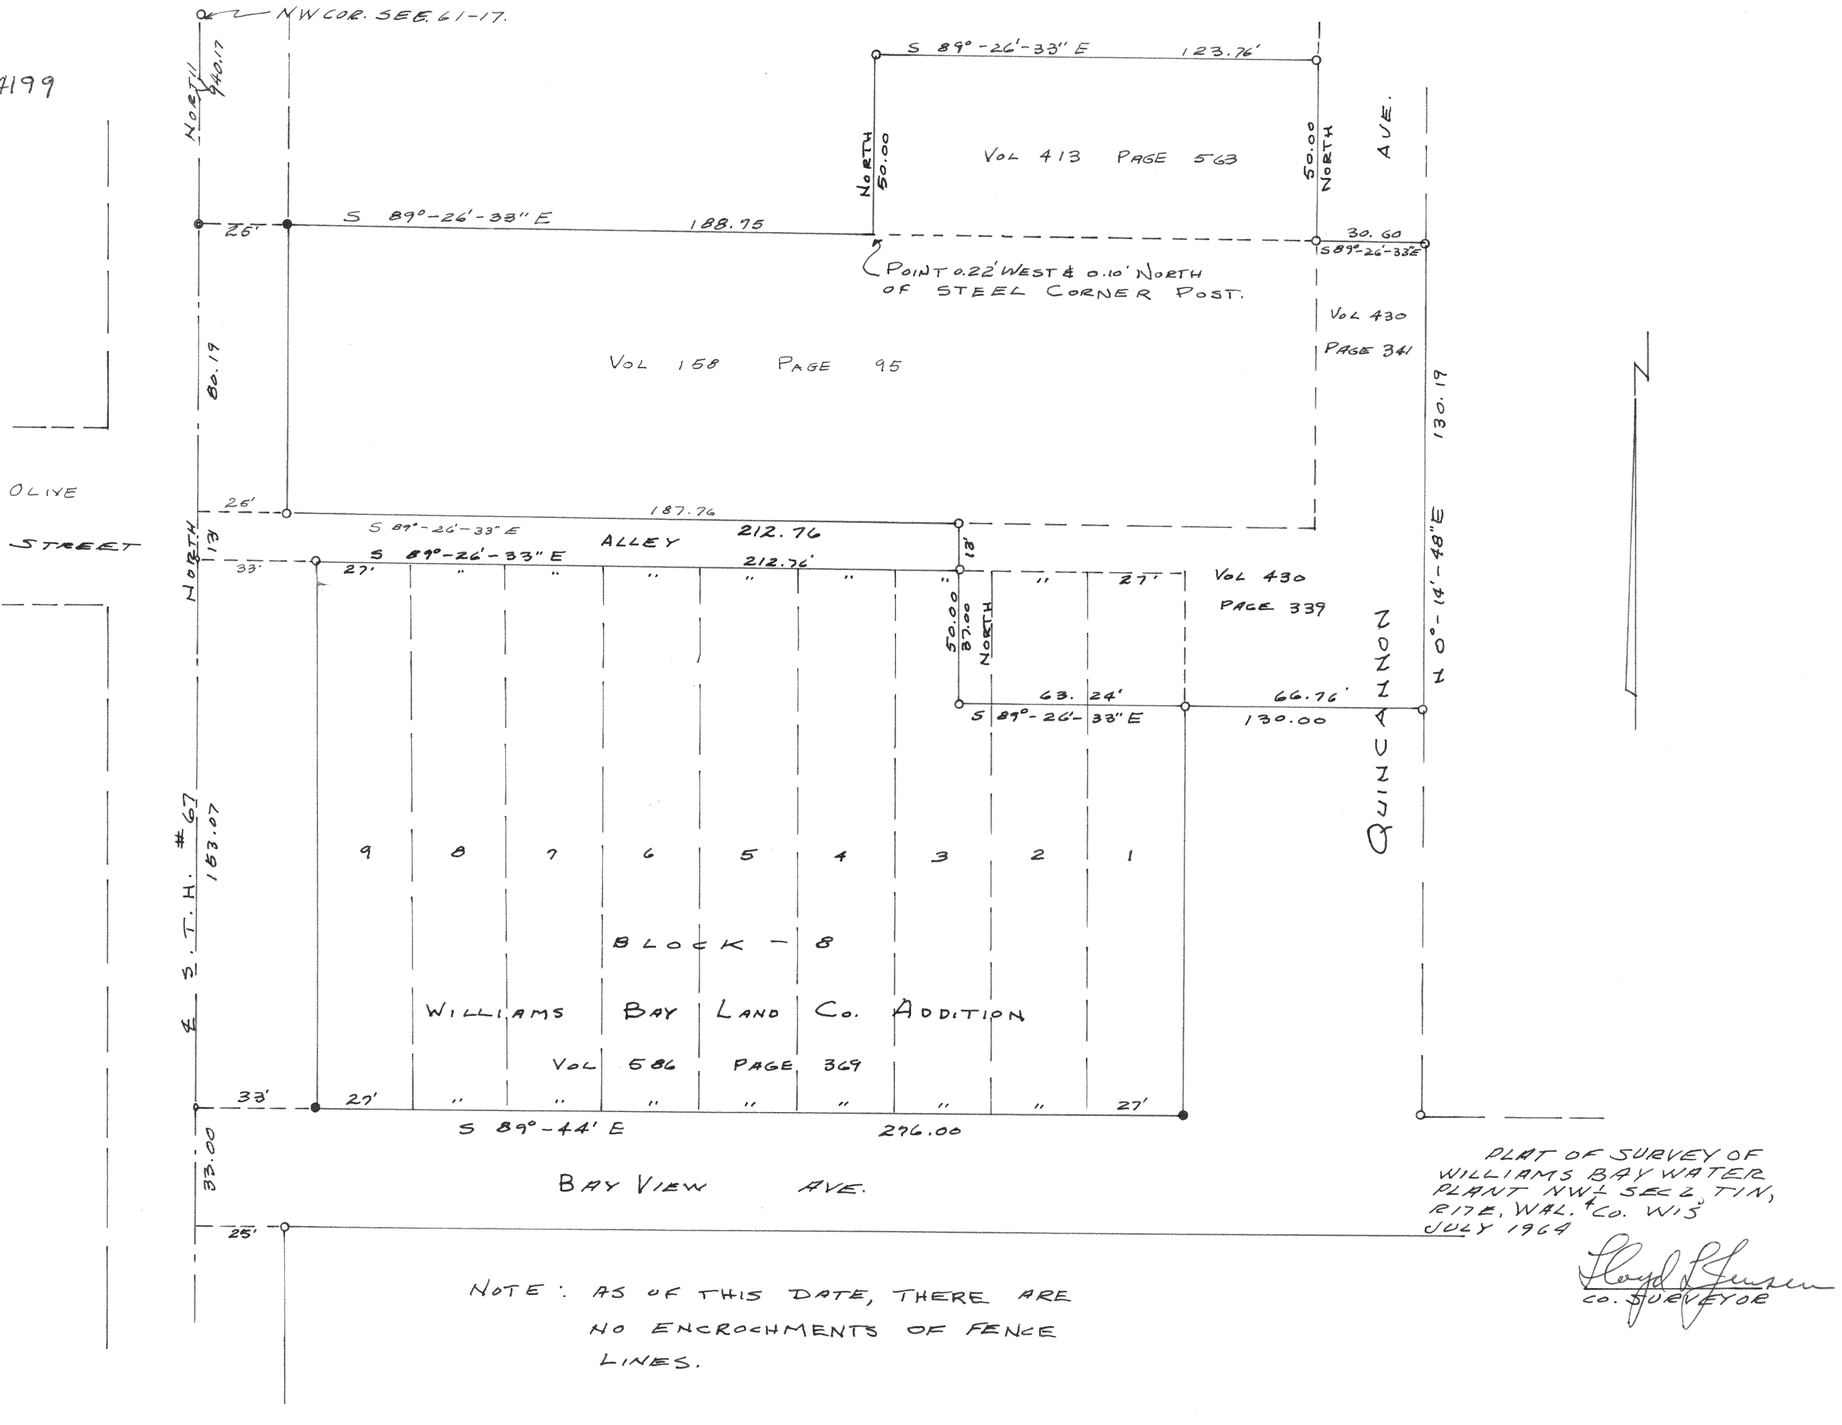

PLAT OF SURVEY OF WILLIAMS BAY WATER PLANT NW¼ SEC 2, T1N, R17E, WAL. CO. WIS. JULY 1964

Floyd L. Jensen
CO. SURVEYOR

NOTE: AS OF THIS DATE, THERE ARE NO ENCROCHMENTS OF FENCE LINES.