
4200

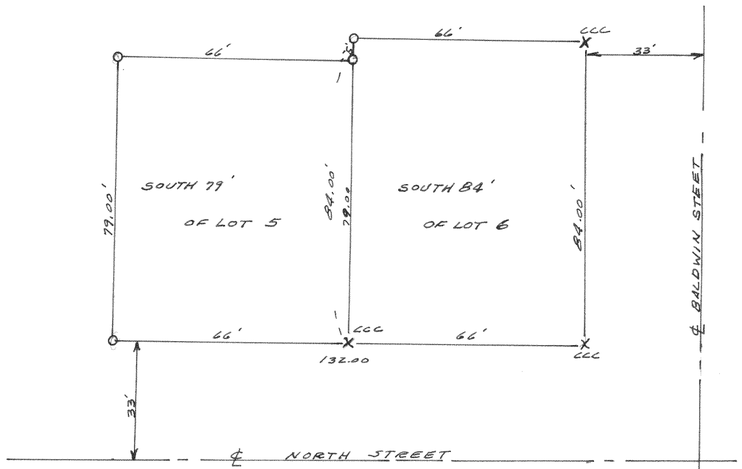

PLAT OF SURVEY OF
THE SOUTH 84 FEET OF LOT 6 AND
THE SOUTH 79 FEET OF LOT 5, BLOCK
9 OF THE ORIGINAL PLAT OF THE
VILLAGE OF SHARON, WALWORTH
COUNTY, WISCONSIN.
DEC. 1963

Floyd L Jensen
COUNTY SURVEYOR

4201

PLAT OF SURVEY OF
LOT 3 AND 4 BLOCK 3 OF FONTANA-
ON-GENEVA LAKE, WALWORTH
COUNTY, WISCONSIN
JANUARY 1964

Floyd L Jensen
SURVEYOR

