
426

#4202

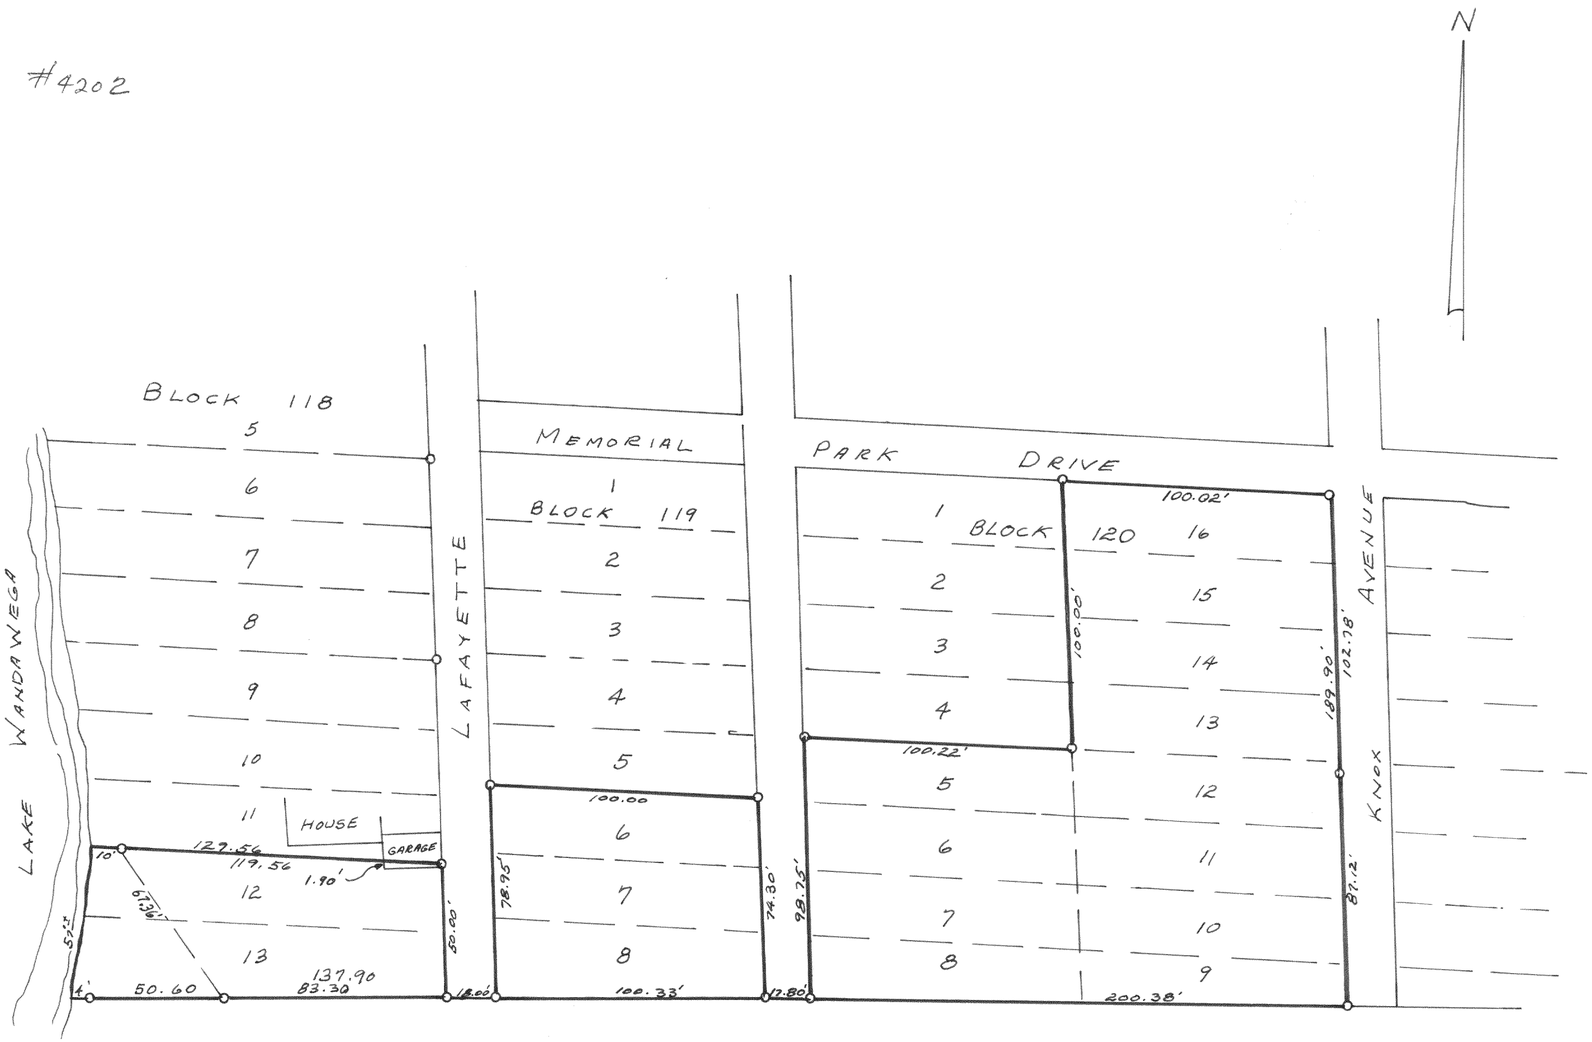

PLAT OF SURVEY

OF

LOT 12-13 BLOCK 118, LOTS 6-7-8

BLOCK 119, LOTS 5-6-7-8-9-10-11-12-

13-14-15-16 BLOCK 120, LAKE Wandawega Subd.

T3N, R16E, WALWORTH COUNTY, WIS

AUG 1964

Floyd L Jensen

CO. SURVEYOR