
#4203

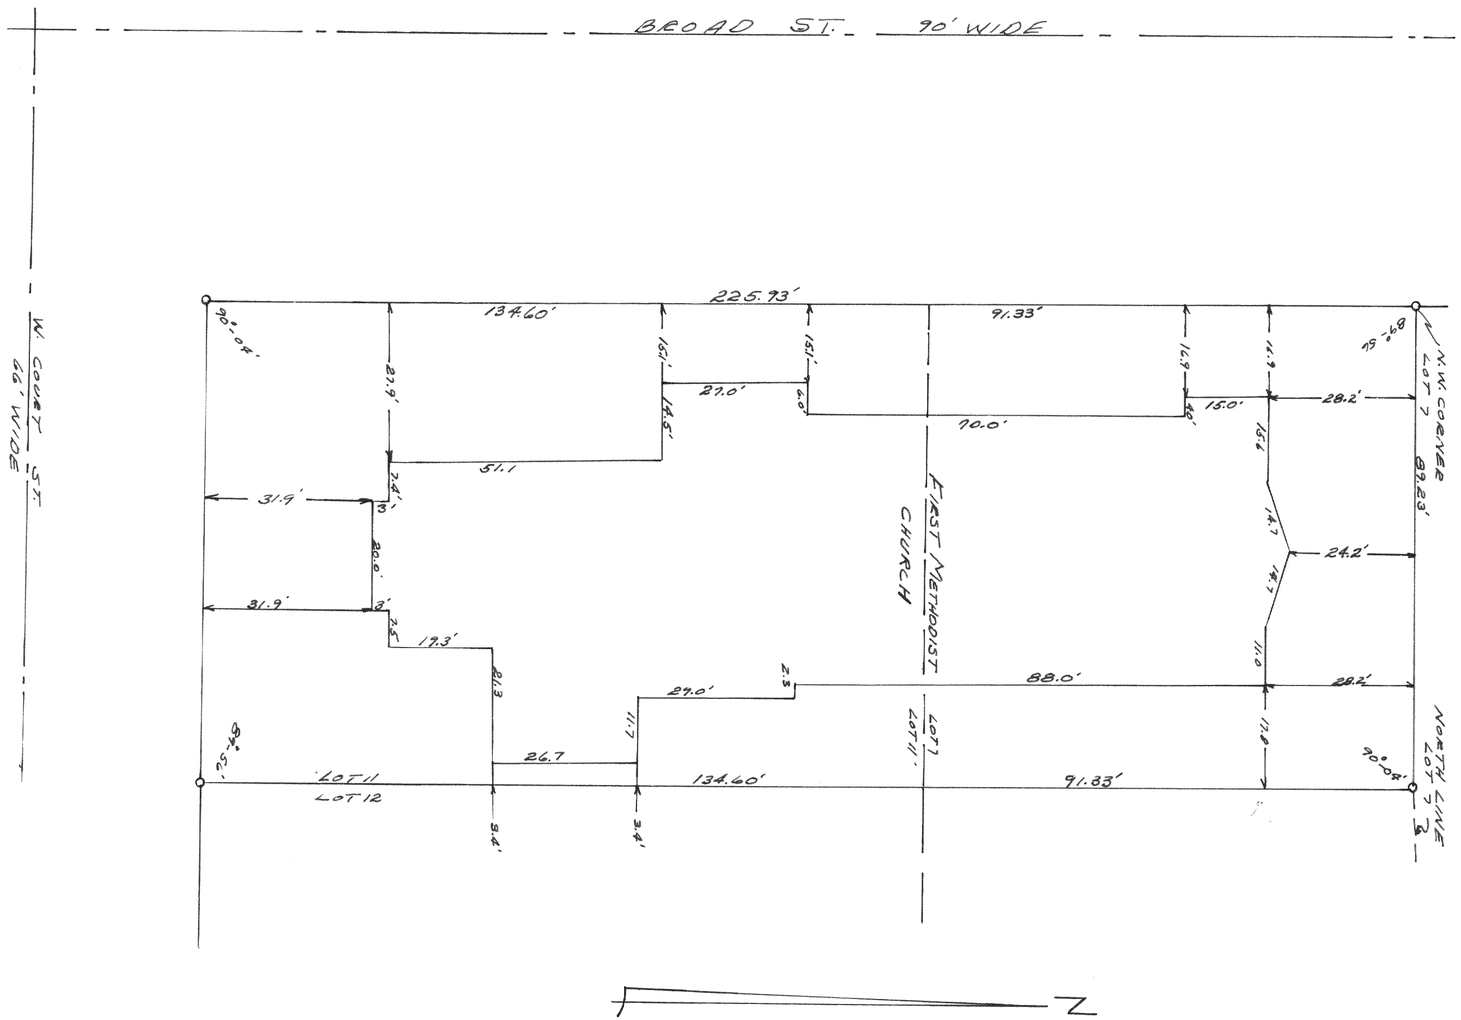

PLAT OF SURVEY OF
LOT 11 AND THE WEST 89.23'
OF LOT 7, BLOCK 16, ORIGINAL
PLAT, CITY OF ELKHORN,
WALWORTH COUNTY, WIS.
Oct. 1964

Lloyd S. Jensen
CO. SURVEYOR