

2794

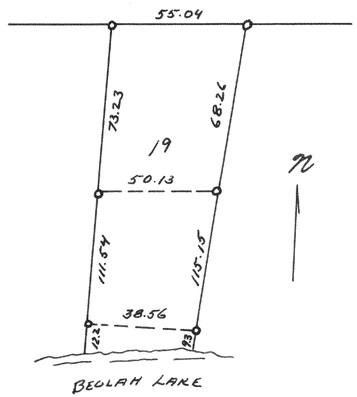


Plat of Survey of Lot 19
Fiemba Sub. T 4 N R 18 E
July 1953 LLJ CS

2797

Plat of Survey of Lots 4-9 (incl.)
Lots 22 & 23 Block 24
Lake Ivanhoe Resort
Nov. 1953 LLJ CS

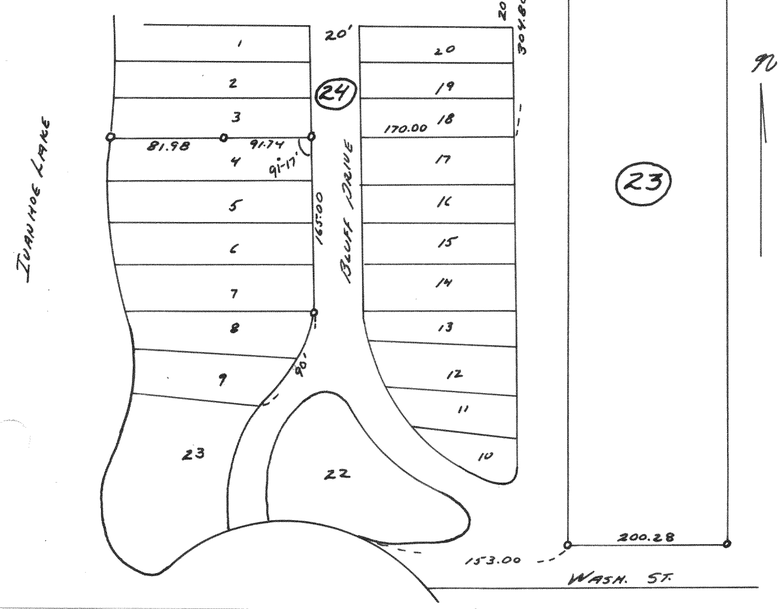


2795

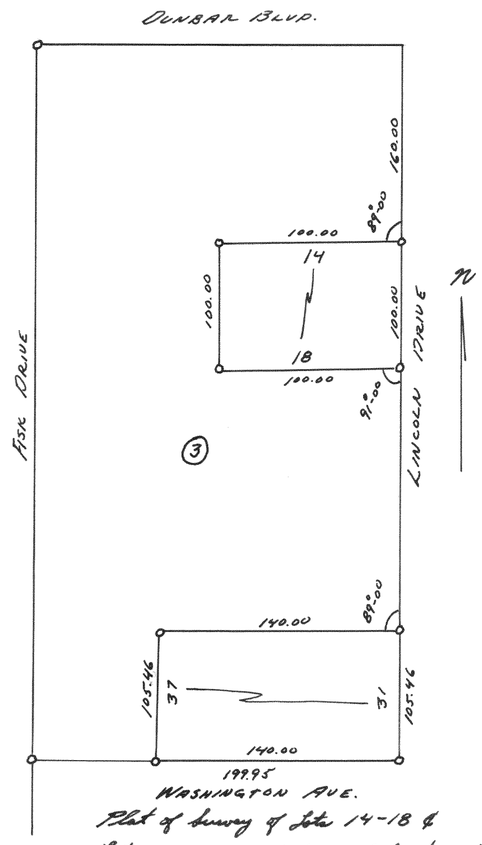


Plat of Survey of Lots 14-18 &
Lots 31-37 Block 3 Lake Ivanhoe
Resort May 1953 LLJ CS

2798

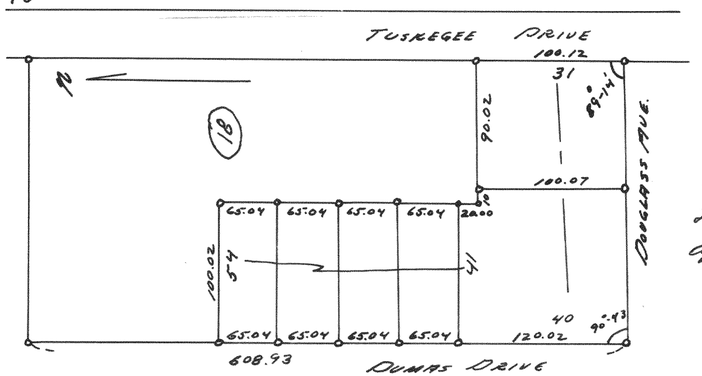

Plat of Survey of
Lots 31-54 Block 18
Lake Ivanhoe Resort
April 53 LLJ CS

2796

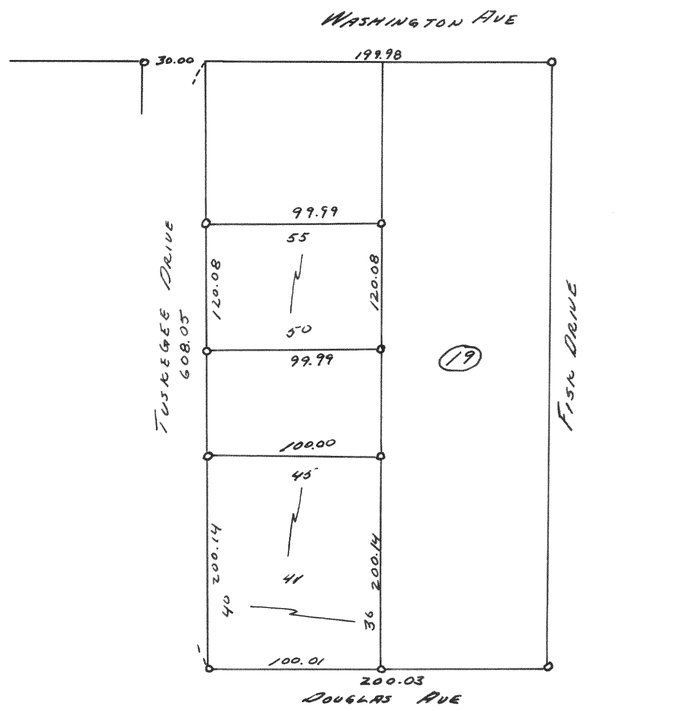

Plat of Survey of Lots
36-45 and 50-55 Blk. 19 Lake Ivanhoe
May 1953 LLJ CS