
#4209

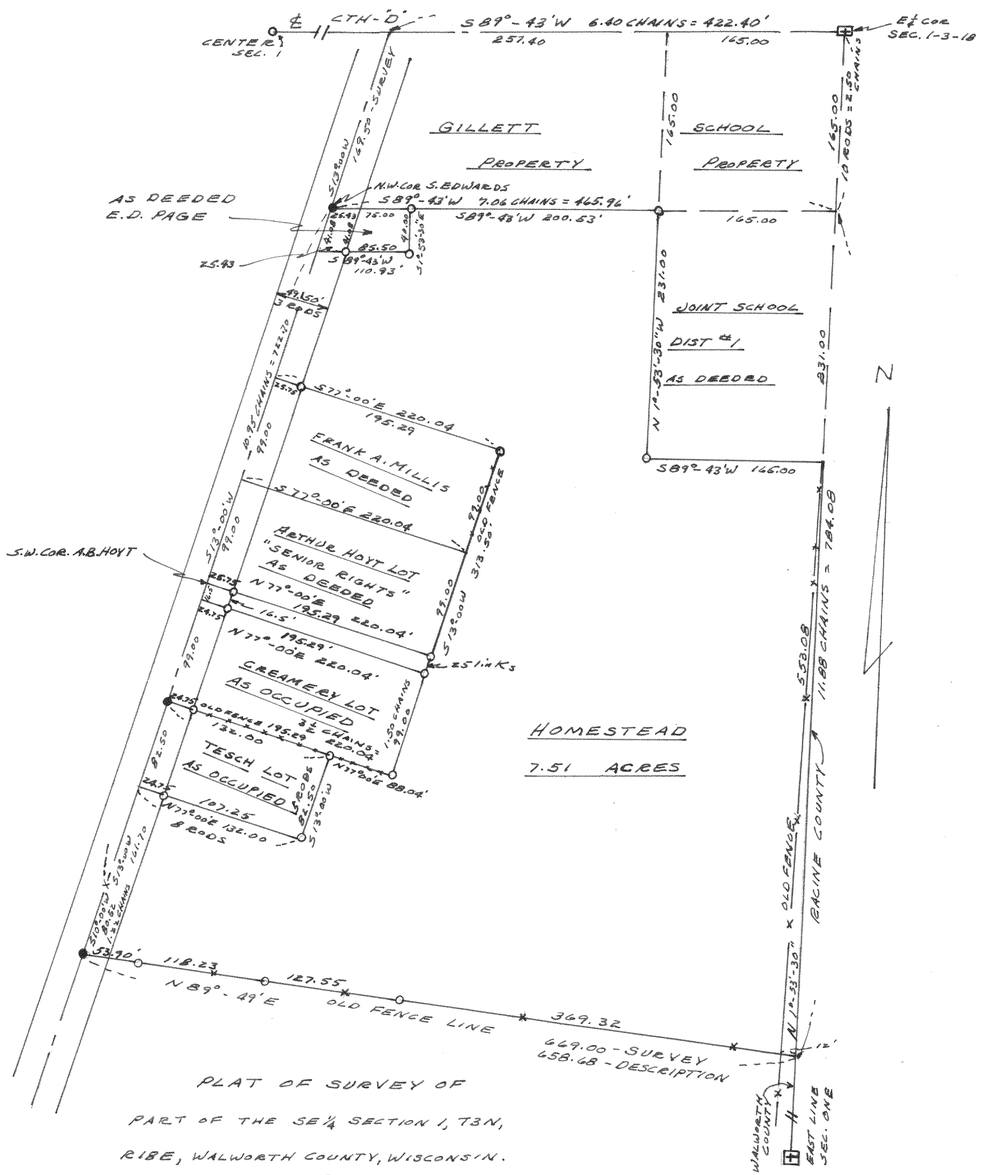

PLAT OF SURVEY OF

PART OF THE SE¼ SECTION 1, T3N,


R18E, WALWORTH COUNTY, WISCONSIN.

DEC. 12, 1963

Floyd S. Jensen

COUNTY SURVEYOR

#4210

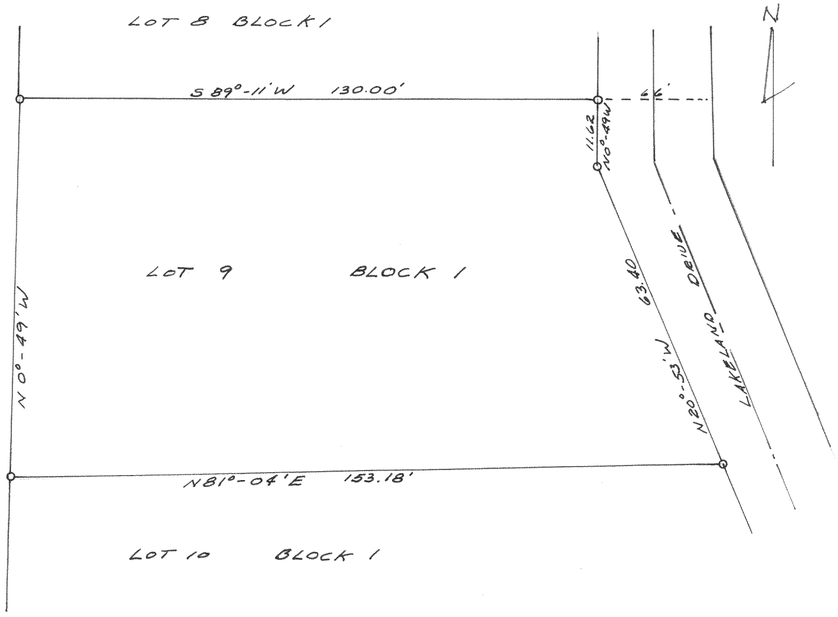

PLAT OF SURVEY OF

LOT 9, BLOCK 1, BROOKWOOD

SUBDIVISION SW¼ OF NW¼

SECTION 18, T1N, R17E

WALWORTH COUNTY, WISCONSIN.

FEB 6, 1964

Floyd S. Jensen

COUNTY SURVEYOR