#4209

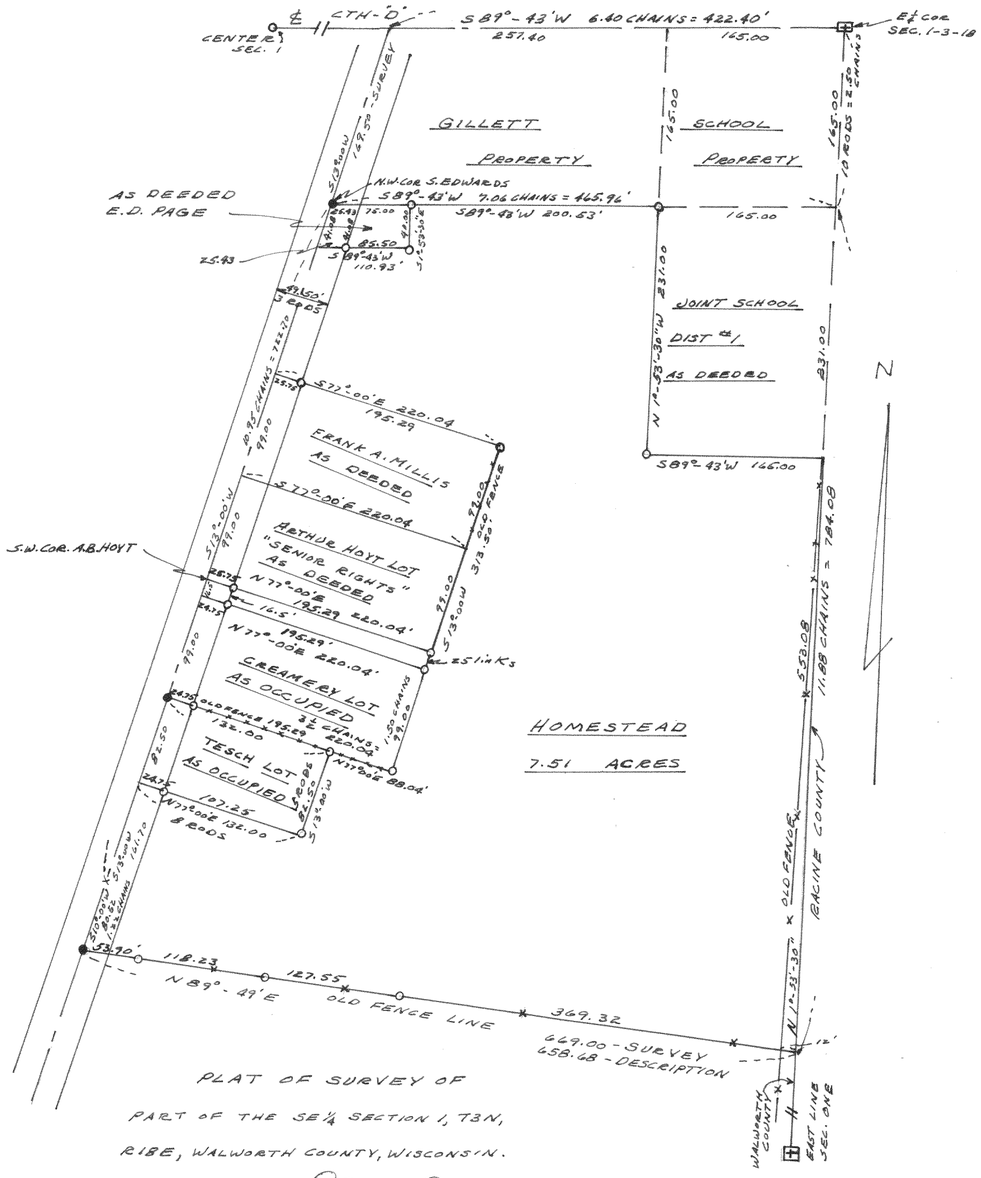

PLAT OF SURVEY OF

PART OF THE SE¼ SECTION 1, T3N, R18E, WALWORTH COUNTY, WISCONSIN.

DEC. 12, 1963

Floyd S Jensen
COUNTY SURVEYOR

#4210

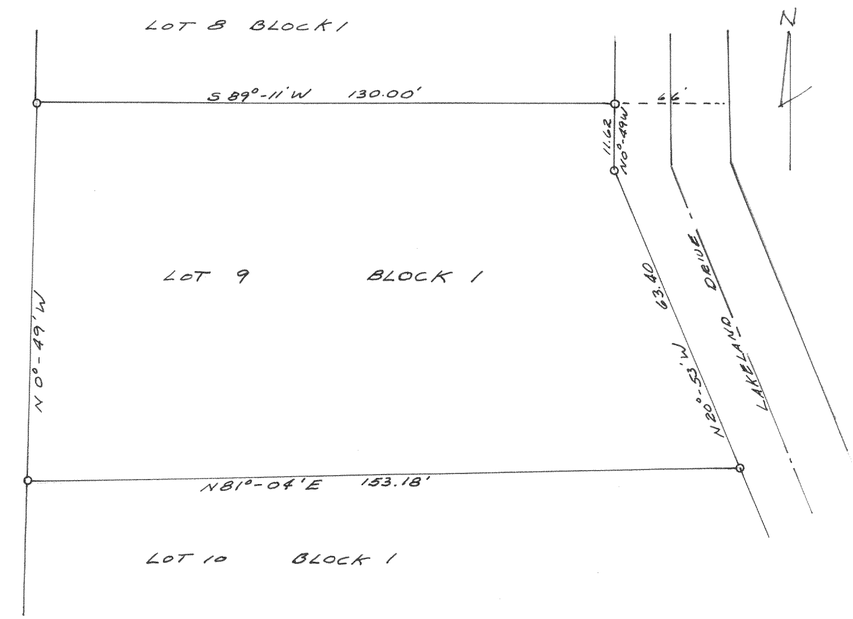

PLAT OF SURVEY OF

LOT 9, BLOCK 1, BROOKWOOD SUBDIVISION SW¼ OF NW¼ SECTION 18, T1N, R17E WALWORTH COUNTY, WISCONSIN.

FEB 6, 1964

Floyd S Jensen
COUNTY SURVEYOR