
#4223

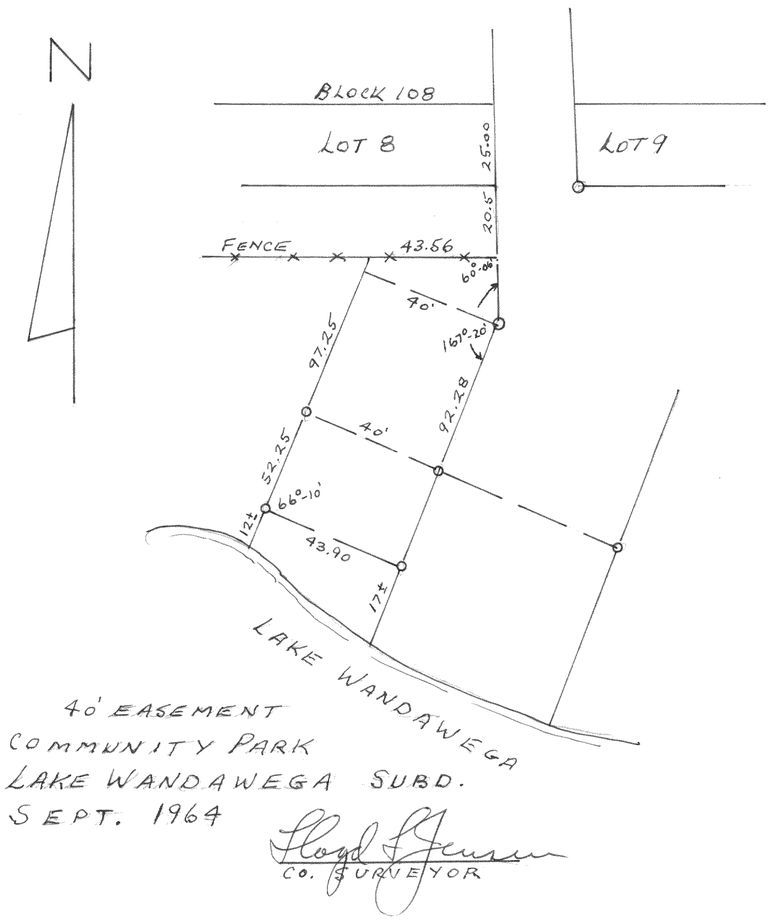


40' EASEMENT
COMMUNITY PARK
LAKE WANDAWEGA SUBD.
SEPT. 1964

Lloyd L. Jensen
CO. SURVEYOR

#4224

PLAT OF SURVEY OF
LOTS A AND B, JIRA FARM
SE¼, SEC. 29-3-18.

OCT. 5, 1964 Lloyd L. Jensen
CO. SURVEYOR

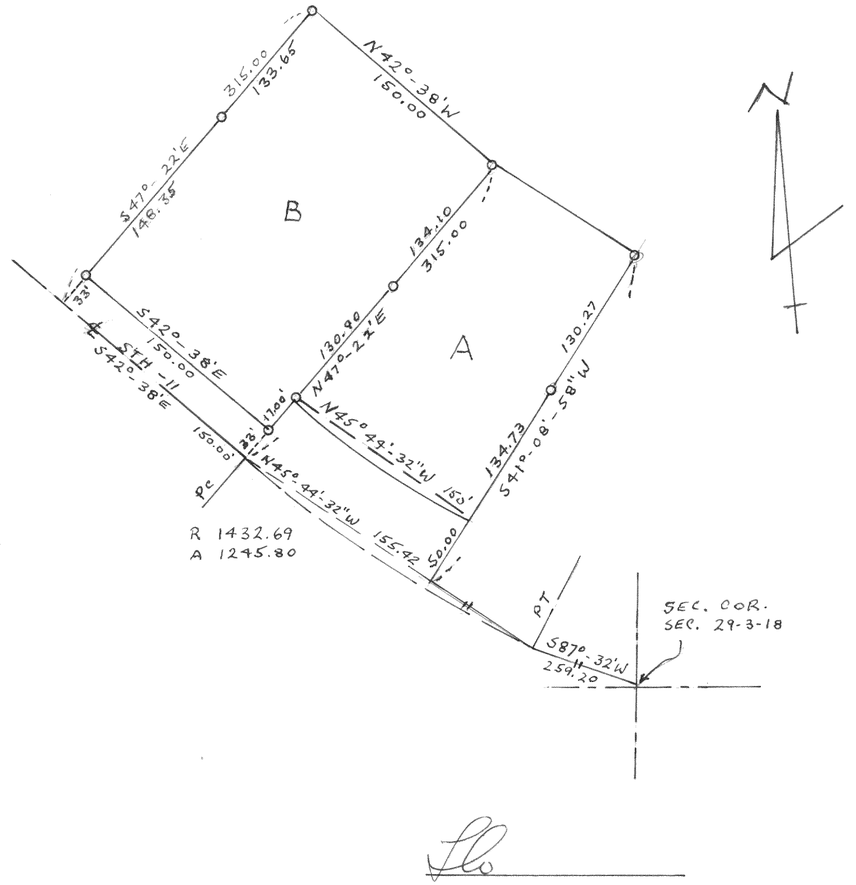

R 1432.69
A 1245.80

Lloyd L. Jensen