~~442~~
444


#4226

PLAT OF SURVEY
OF

LOTS 1 & 4 - BLOCK - 11 WILLIAMS 2ND ADDITION TO THE VILLAGE OF WILLIAMS BAY, WALWORTH COUNTY, WISCONSIN.

OCT. 1964

Floyd L Jensen
CO. SURVEYOR

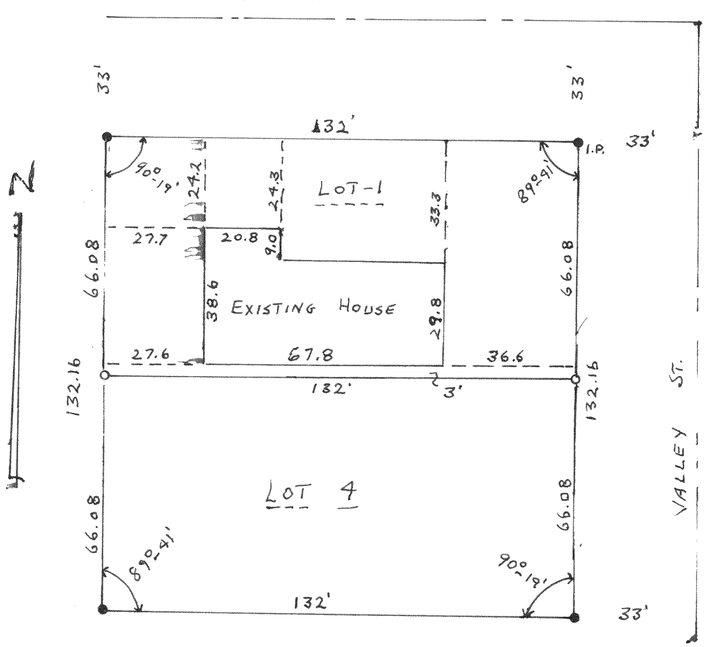

#4227

PLAT OF SURVEY OF

LOT 119, PLAT OF THE ORIGINAL CEDAR POINT PARK SUBDIVISION, LOCATED IN SECTION 6, T1N R17E, VILLAGE OF WILLIAMS BAY, WALWORTH COUNTY, WISCONSIN

JANUARY 1965

Floyd L Jensen
CO. SURVEYOR

