
#4237 PLAT OF SURVEY OF

ALL THAT PART OF LOT 4 LAUDERDALE PARK THAT LIES SOUTH OF THE PRIVATE ROAD CROSSING SAID LOT, LOCATED IN THE SOUTHWEST 1/4 OF SECTION 25, T4N R16E, WALWORTH COUNTY, WISCONSIN.

NOV. 1964

Floyd L Jensen
CO. SURVEYOR

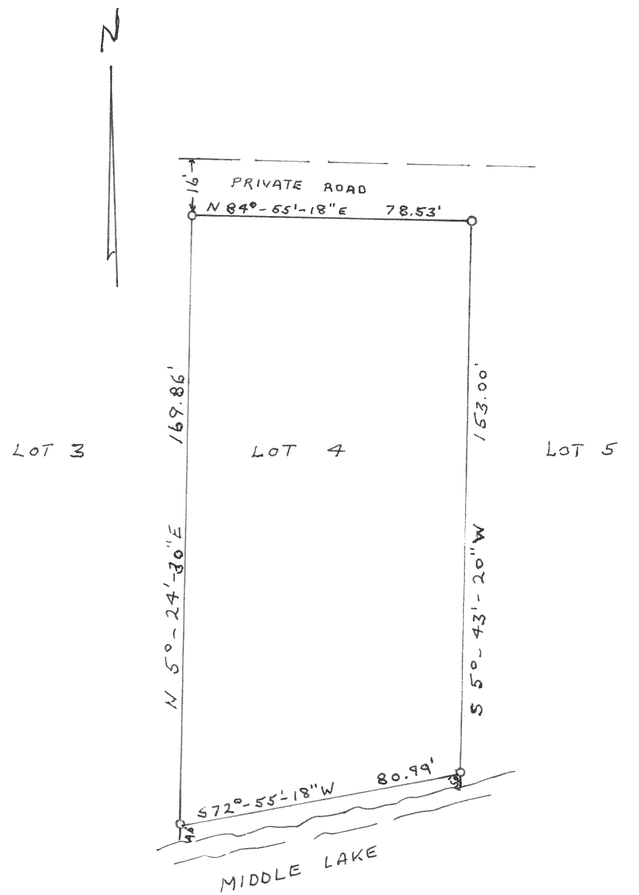

#4238 PLAT OF SURVEY OF

LAND LOCATED IN THE SOUTHEAST 1/4 OF SECTION 25, T4N R16E OF WALWORTH COUNTY, WISCONSIN.

JULY 27
1964

Floyd L Jensen
CO. SURVEYOR

