
#4245

PLAT OF SURVEY OF
LAND IN THE SE¼ - SECTION 19
T4N, R18E, WAL. CO. WIS.
SEPT. 1964 Floyd L Jensen
CO. SURVEYOR

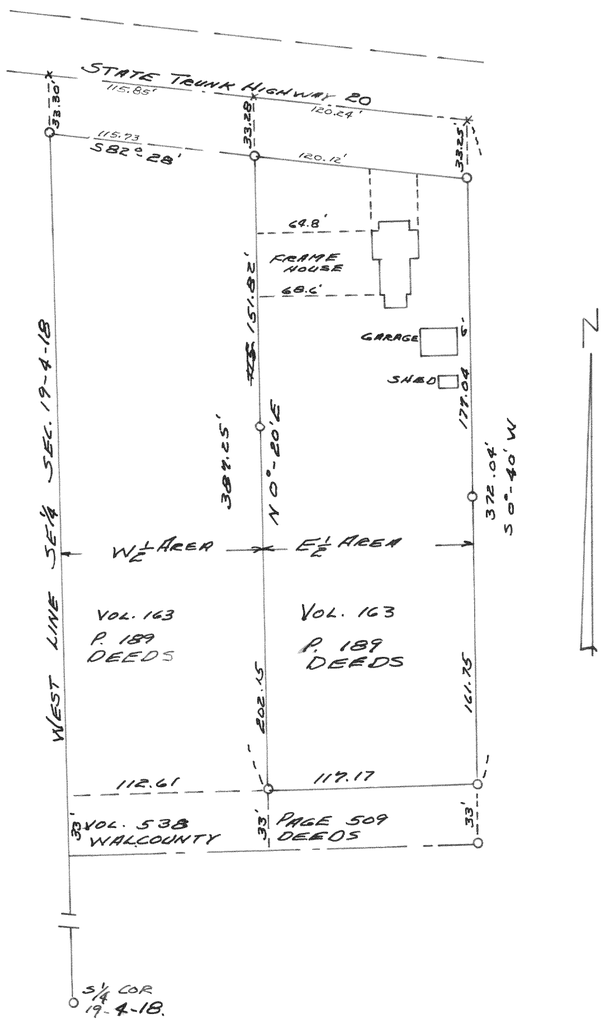

#4246

PLAT OF SURVEY OF
PART OF LOT 2 BLOCK 12, OF
THE ORIGINAL PLAT TO THE
VILLAGE OF EAST TROY,
WAL. CO. WIS.
MAR 1964 Floyd L Jensen
COUNTY SURVEYOR

