#4247

PLAT OF SURVEY OF
PART OF BLOCK B
BOULEVARD SUBDIVISION
CITY OF LAKE GENEVA, WAL.
CO. WIS.

SEPT. 1964

Floyd L. Jensen
CO. SURVEYOR

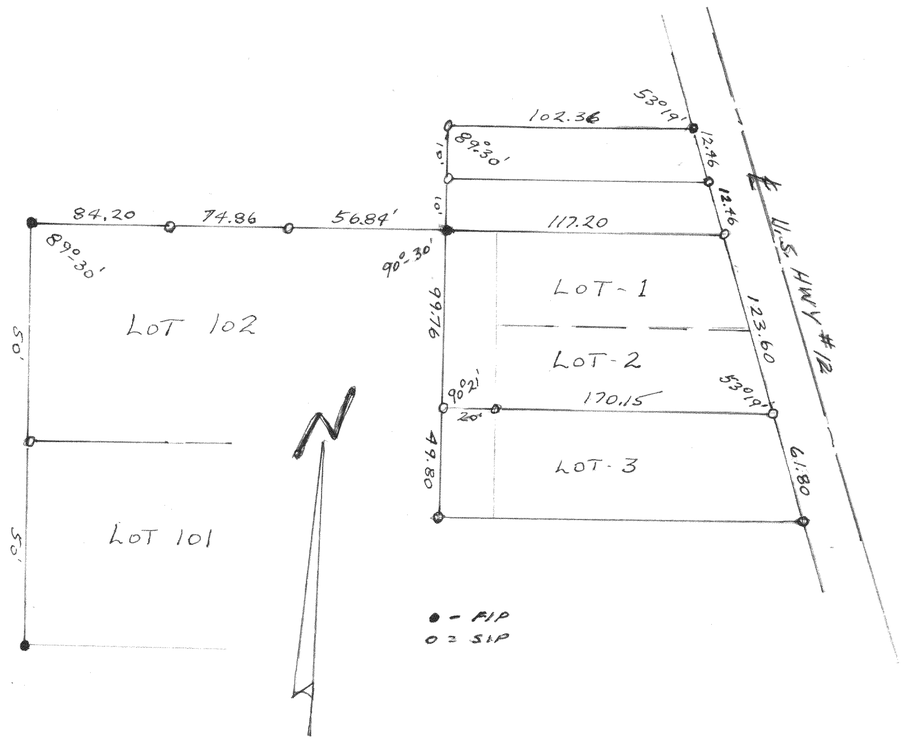

#4248

PLAT OF SURVEY OF
PART OF BLOCK 28 OF
THE ORIGINAL PLAT OF
LAKE GENEVA, WAL. CO. WIS.
SEPT. 1964
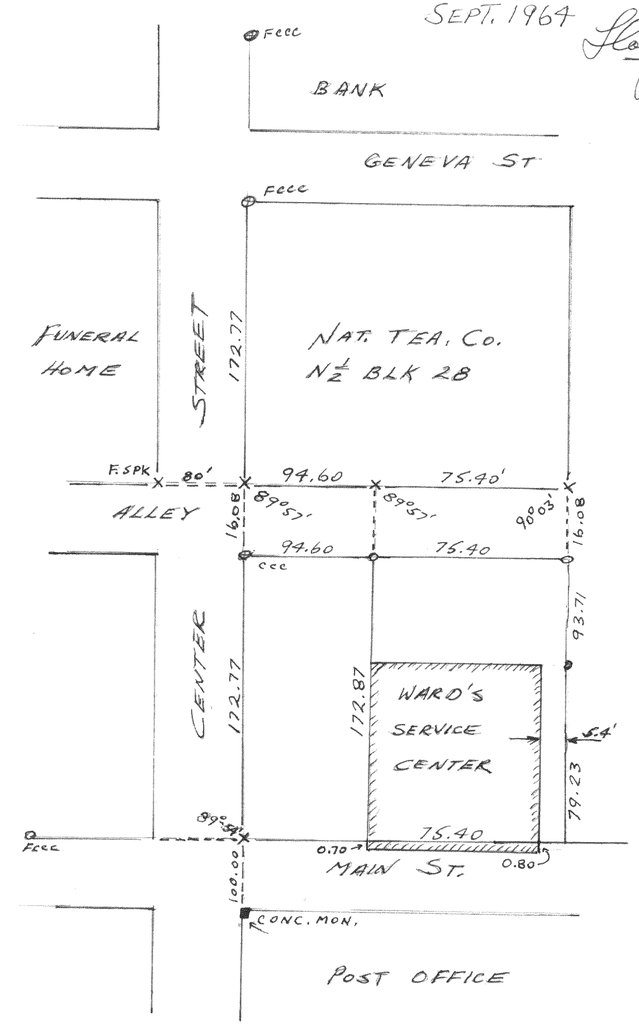
Floyd L. Jensen
CO. SURVEYOR