

#2809

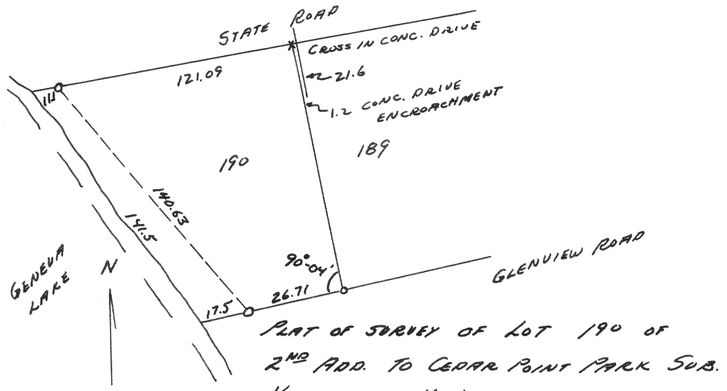


PLAT OF SURVEY OF LOT 190 OF 2ND ADD. TO CEDAR POINT PARK SUB. VILLAGE OF WM'S BAY OCT 1953
LLJ
CS

#2810

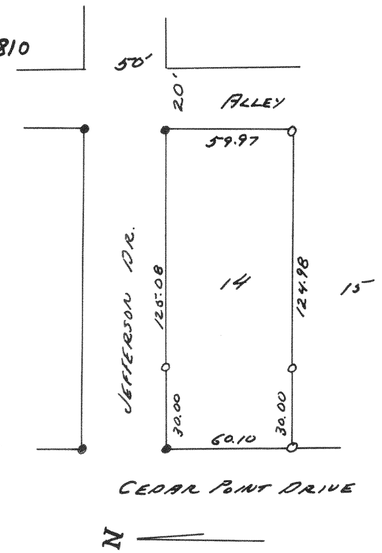

PLAT OF SURVEY OF LOT 14 CEDAR POINT PARK, ORIGINAL, VILLAGE OF WM'S BAY
NOV. 1953
LLJ
CS

#2811

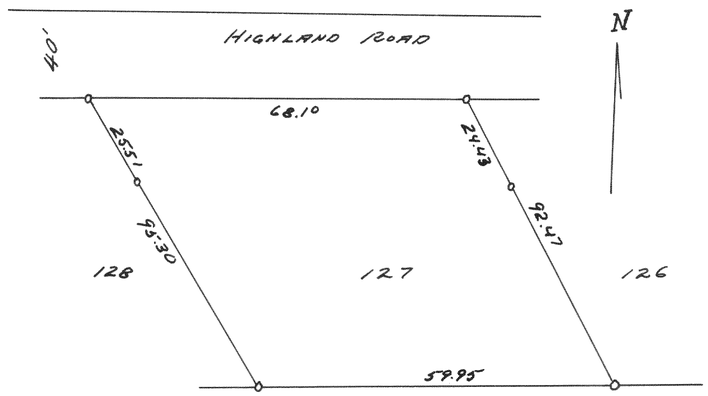


PLAT OF SURVEY OF LOT 127 2ND ADD CEDAR POINT PARK VILLAGE OF WILLIAMS BAY
SEPT. 1953
LLJ
CS

#2812


PLAT OF SURVEY OF LOT 69. CEDAR POINT PARK, ORIGINAL, VILLAGE OF WM'S BAY
OCT. 1953
LLJ
CS

#2813

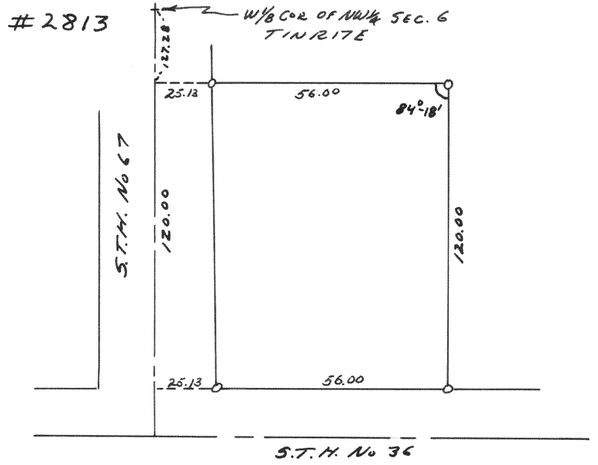

PLAT OF SURVEY OF LAND LOCATED IN SW1/4 NW1/4 SEC. 6. T1N R17E VILLAGE OF WM'S BAY
AUG. 1953
LLJ
CS

#2814

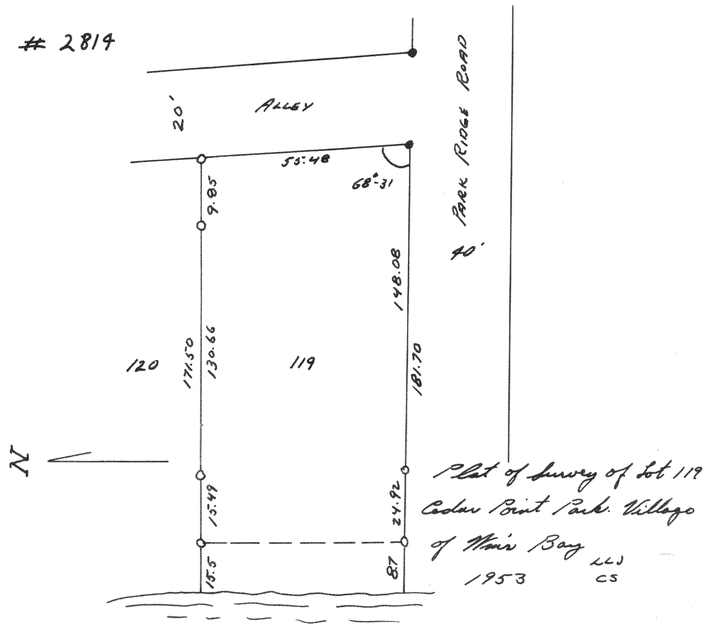

Plat of Survey of Lot 119 Cedar Point Park Village of Wm's Bay
1953
LLJ
CS