
#4249


PLAT OF SURVEY OF
LOT 8 BLOCK 12 LAKE
GENEVA MANOR, CITY
OF LAKE GENEVA, WAL
CO. WIS
MAY 10, 1963

Floyd L Jensen
CO. SURVEYOR

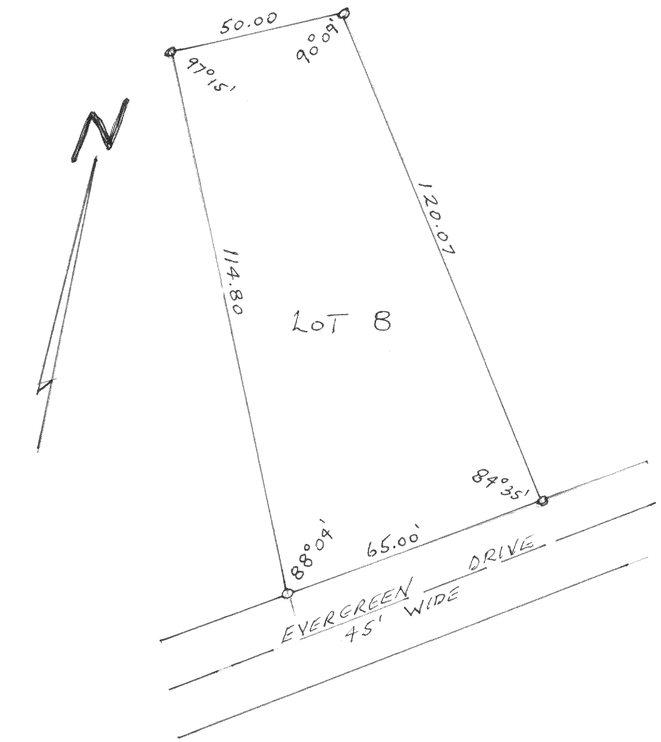

#4250 PLAT OF SURVEY OF
PART OF LOT 25 BLOCK 31
LAKE GENEVA MANOR, CITY OF
LAKE GENEVA, WAL. CO. WIS.
MAY 1962

Floyd L Jensen
CO. SURVEYOR

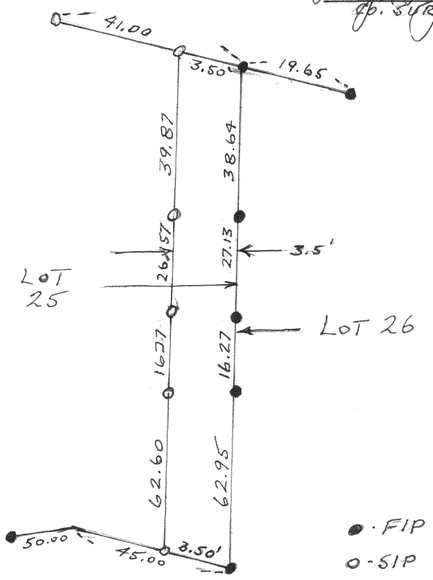

#4251 PLAT OF SURVEY OF
LOT 4, BLOCK 31, LAKE
GENEVA MANOR, CITY OF
LAKE GENEVA, WAL. CO. WIS
MAY 1963

Floyd L Jensen
CO. SURVEYOR

