
#4258 PLAT OF SURVEY OF
LOT 16 BLOCK 5 TRIPP'S
ADDITION TO THE CITY OF
WHITEWATER, WALWORTH COUNTY, WIS.

OCT. 1964 Floyd L Jensen
CO. SURVEYOR

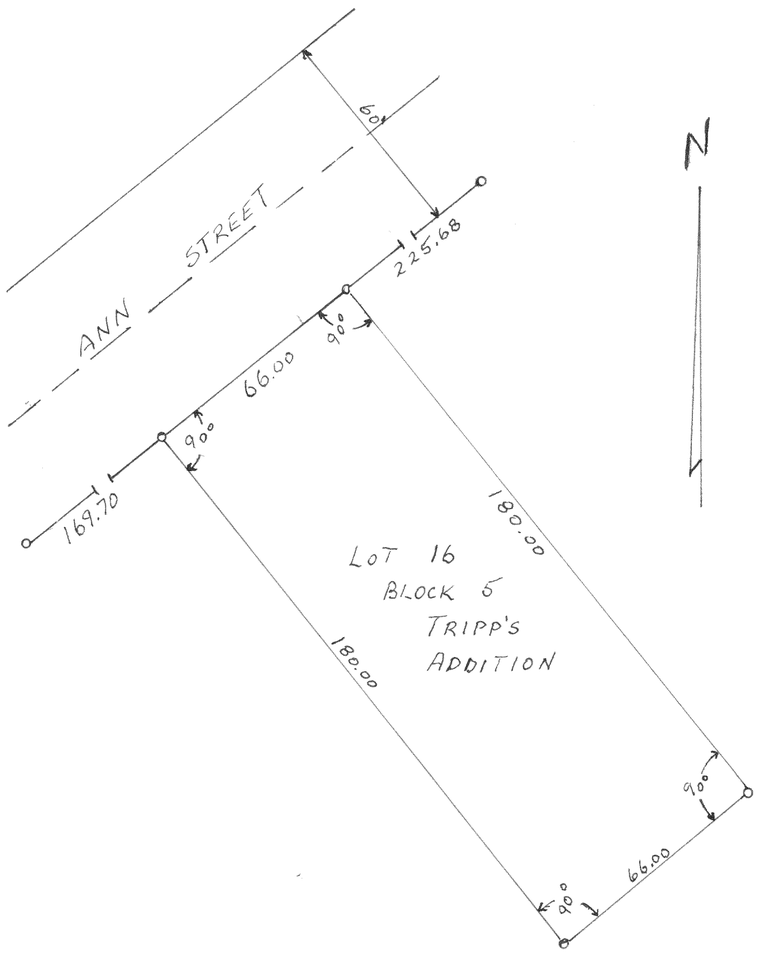

#4259 PLAT OF SURVEY OF
LOT 14, LOT 15, LOT 16 - BLOCK 4
TRIPP'S ADDITION TO THE CITY OF
WHITEWATER, WALWORTH COUNTY, WISCONSIN.

OCT. 1964 Floyd L Jensen
CO. SURVEYOR

