

2815

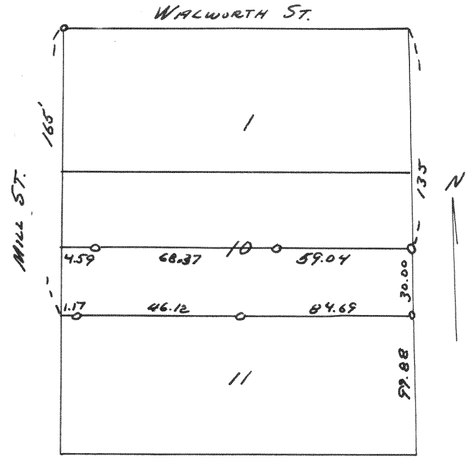


Plat of Survey of Lots 1, 10 & 11
Village of Genoa City, original
June 9, 1953 LLJ CS

2816

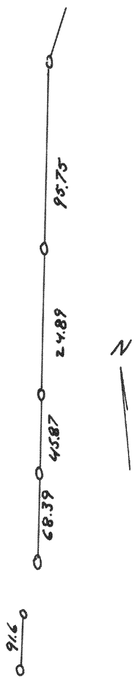


Plat of Survey of East line of
Lot 16 Block 1 Indian Hills Sub
Village of Fontana - on - Geneva Lake
Oct 1953 LLJ CS

2817

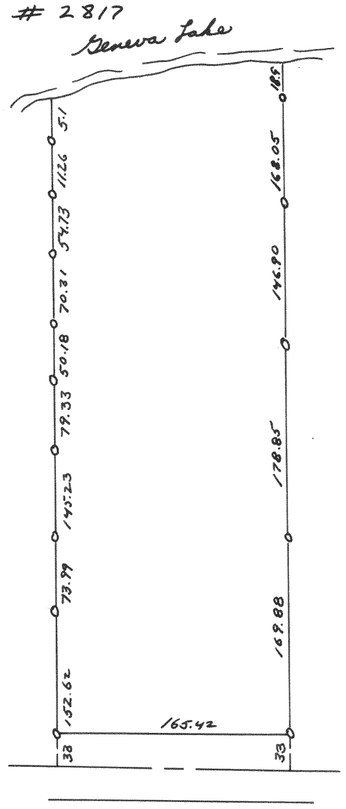

Plat of Survey of Lot 1
of Robert Gardners Sub.
Village of Fontana on Geneva Lake
Aug. 1953 LLJ CS


2818

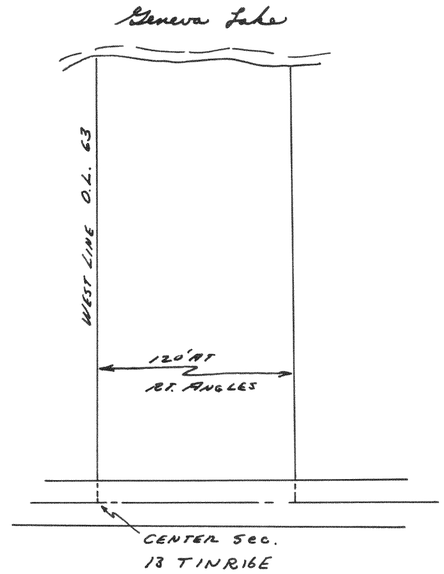


Plat of Survey of West 120 ft.
of O.L. 63 Assessors Plat No. 1
Village of Fontana on Geneva Lake
1953 LLJ CS

2819

Plat of Survey of Lot 1 Block 3
Indian Hills Subdivision
Village of Fontana on Geneva Lake
Oct 1953

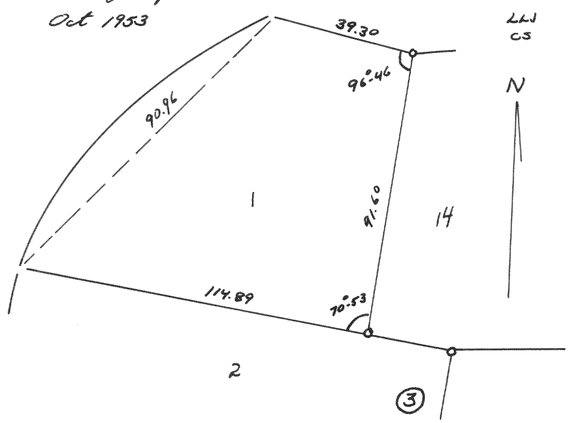

2820

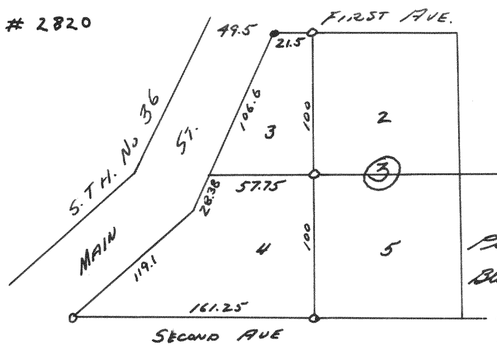

Plat of Survey of West Part of
Block 3 Original Plat Village of
Fontana on Geneva Lake
March 1953 LLJ CS