
#4273

PLAT OF SURVEY OF
OUTLOT 136 NW¼ SECTION 22,
T1N, R16E, VILLAGE OF WALWORTH,
WALWORTH COUNTY, WISCONSIN.

SEPT. 1964 Floyd L Jensen
CO. SURVEYOR

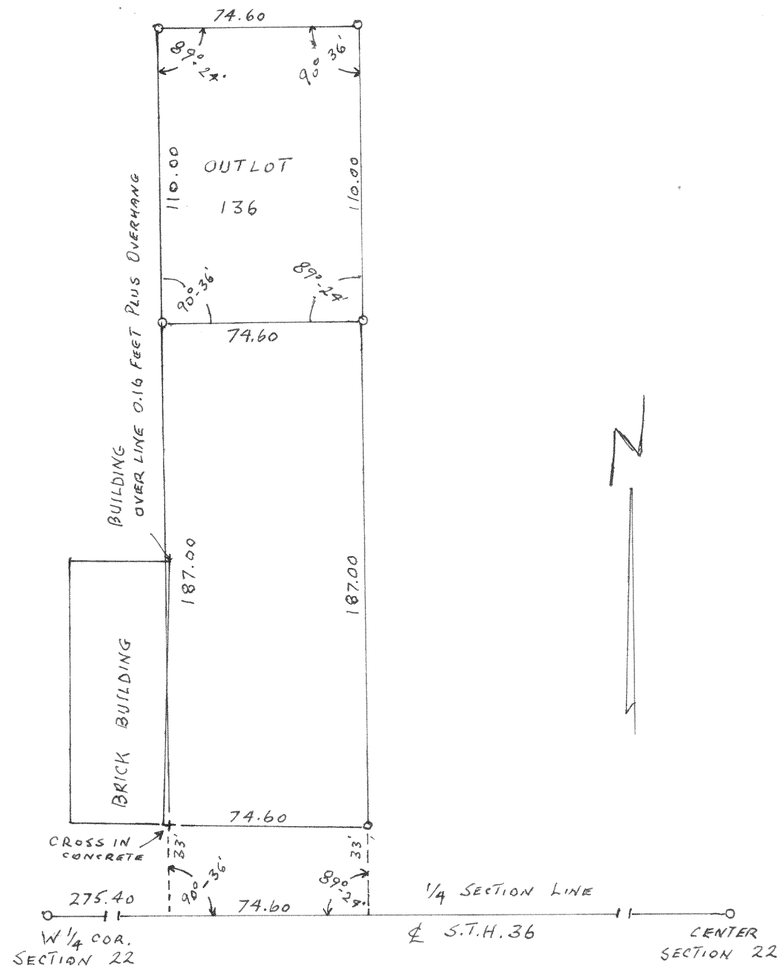

#4274

PLAT OF SURVEY OF
LOT LOCATED IN NE¼
SECTION 2, T1N, R16E
WALWORTH COUNTY, WIS.
SEPT. 1964

Floyd L Jensen
COUNTY SURVEYOR

