
#4279

PLAT OF SURVEY OF
A PARCEL LOCATED IN THE
SE¼ OF SEC 19, T3N, R17E
WALWORTH COUNTY, WIS.
APRIL 1962

Floyd L Jensen
CO. SURVEYOR

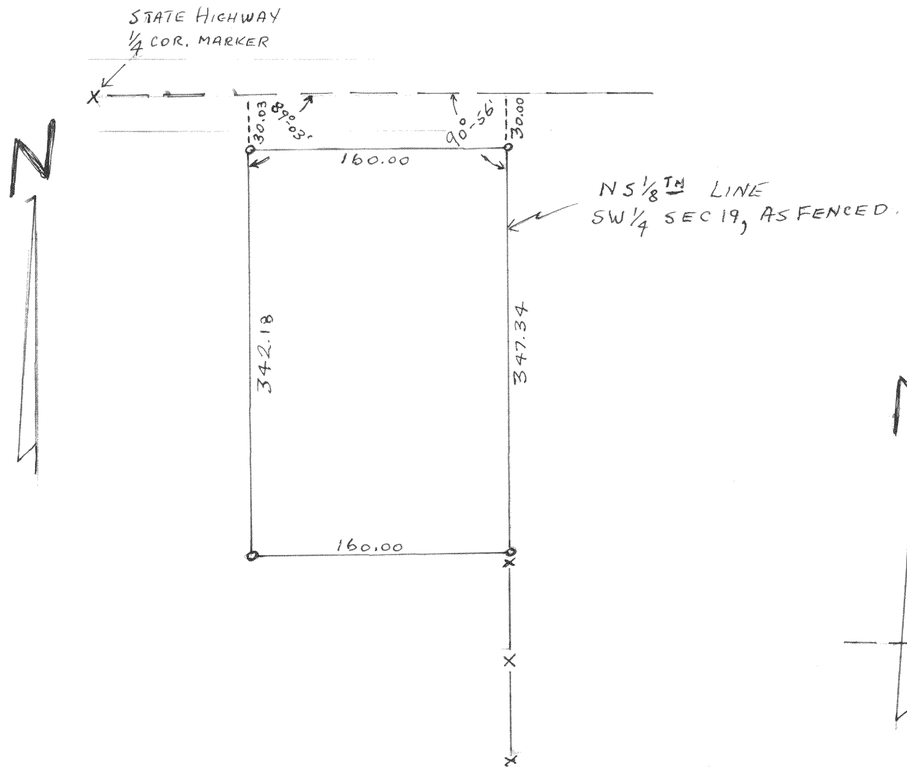

#4280

PLAT OF SURVEY OF
LAND LOCATED IN THE
NE¼ OF SECTION 19
T3N R17E WAL. Co, WIS
SEPT 1962

Floyd L Jensen
CO. SURVEYOR

