
#4292 PLAT OF SURVEY OF

A PARCEL OF LAND LOCATED IN THE NORTHEAST 1/4 OF SECTION 9 T4N, R15E, CITY OF WHITEWATER WALWORTH COUNTY, WISCONSIN.

AUGUST 1964 Floyd L Jensen CO. SURVEYOR

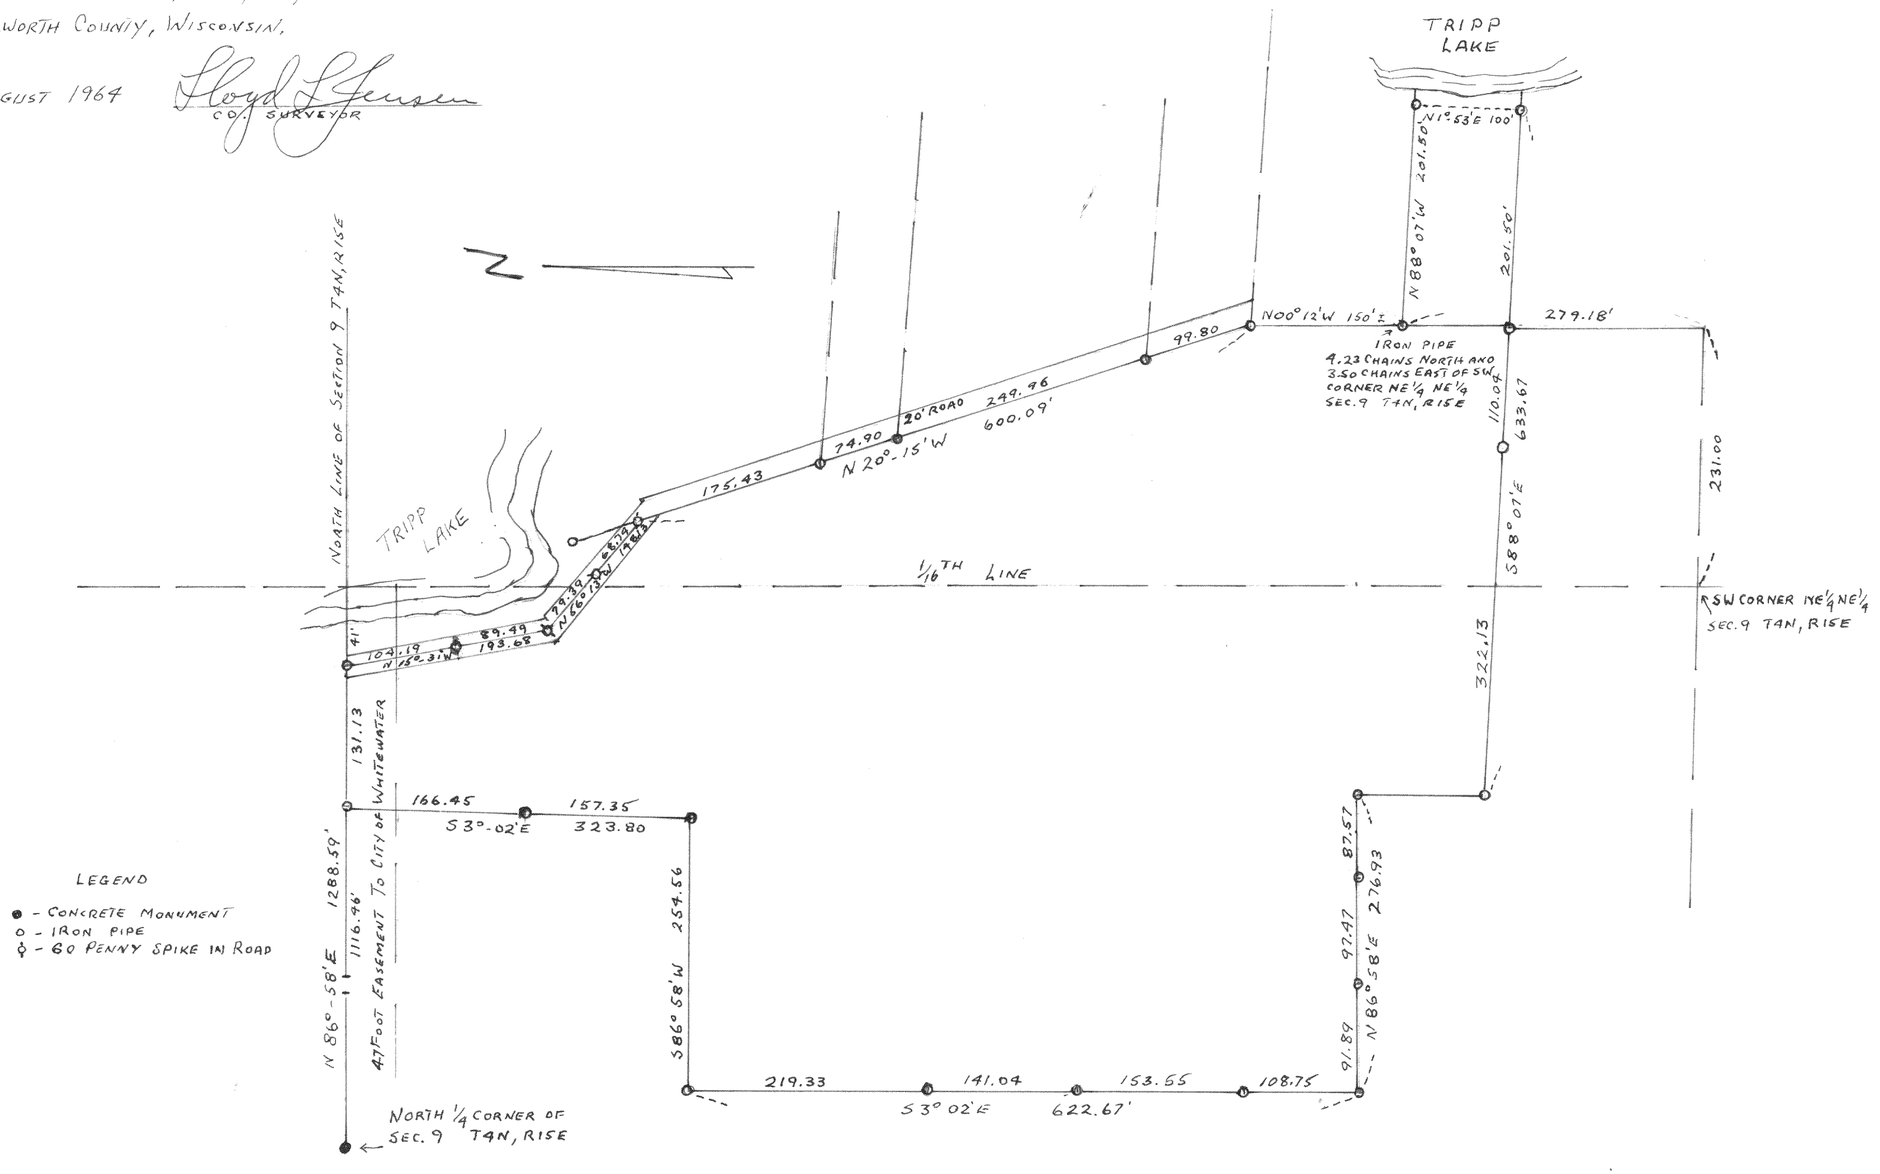

LEGEND

● - CONCRETE MONUMENT
o - IRON PIPE
ϕ - 60 PENNY SPIKE IN ROAD