
#4302

PLAT OF SURVEY OF

LOT 31 OF LYNNDALE SUBDIVISION LOCATED IN THE NW¼ SEC 20, T4N, R18E, VILLAGE OF EAST TROY WAL. CO. WIS.

SEPT. 1964

Floyd L Jensen
CO. SURVEYOR

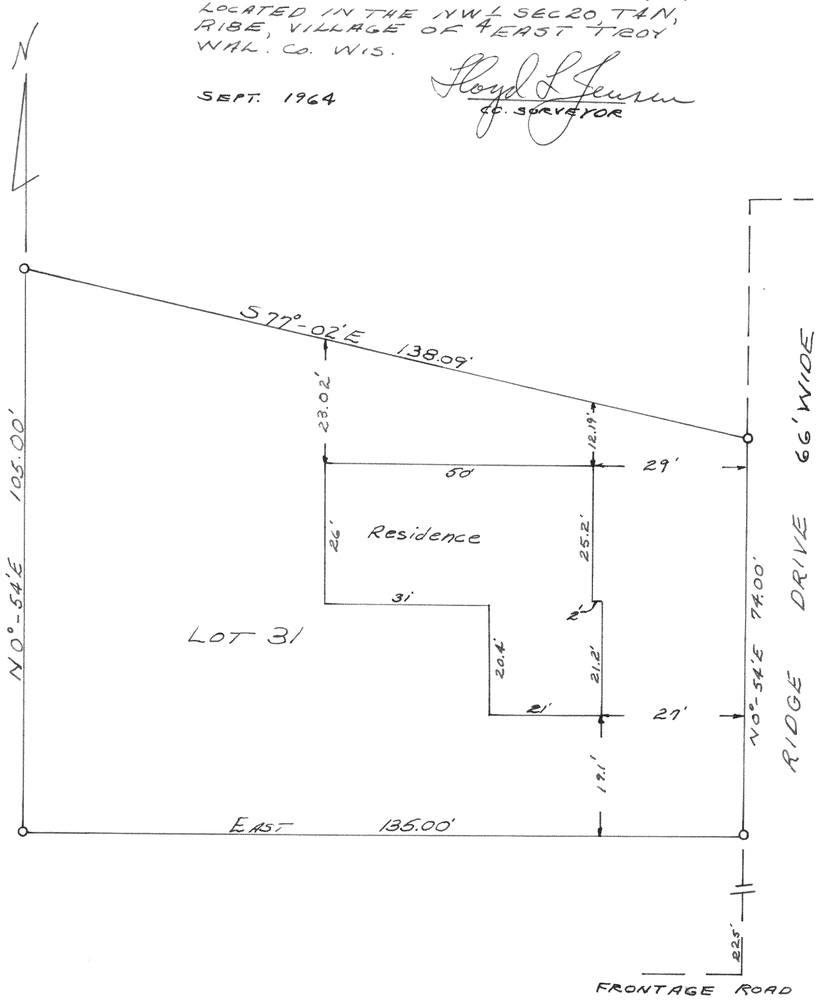

#4303

PLAT OF SURVEY OF

LOT LOCATED IN NE¼ OF SECTION 9 - T4N, R18E, WALWORTH COUNTY, WISCONSIN.

OCT. 12, 1964

Floyd L Jensen
CO. SURVEYOR

