
#4305

PLAT OF SURVEY OF
LOTS 21, 22, 23, EDGEWATER
TERRACE SUBD. LOCATED
IN SEC. 8 & 9 T1N R17E
WALWORTH COUNTY, WIS

APRIL 1964

Floyd L. Jensen
CO. SURVEYOR

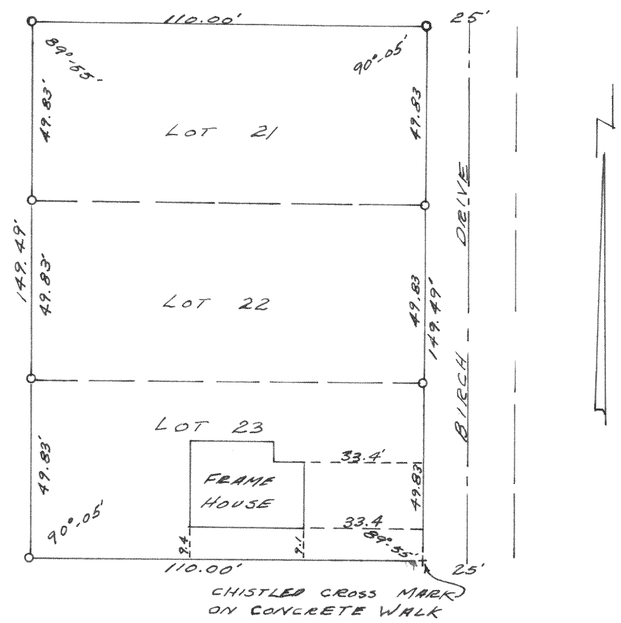

#4306

PLAT OF SURVEY OF

LOTS 85, 88, & 89 LAKE GENEVA
BEACH SUBD. LOCATED IN SW¼ OF
SEC 11, T1N, R17E, WALWORTH COUNTY, WIS

AUG 1964

Floyd L. Jensen
CO. SURVEYOR

