
#2629

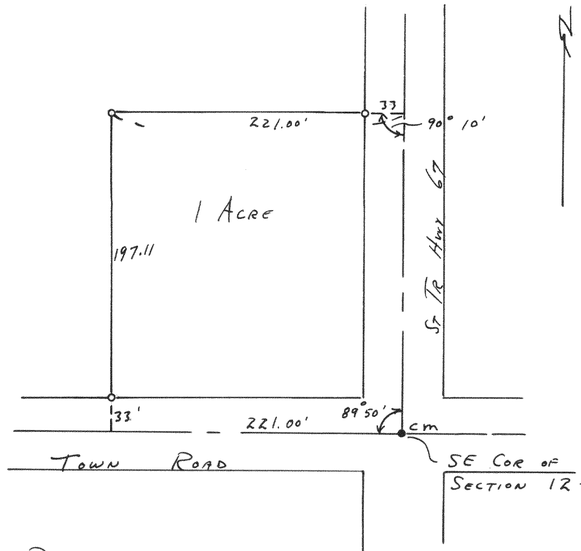


Plat of survey of 1 acre of land located in the South East corner of Section 12, T2N R16E

June 28, 1952

Lloyd L Jensen
County Surveyor

#2630

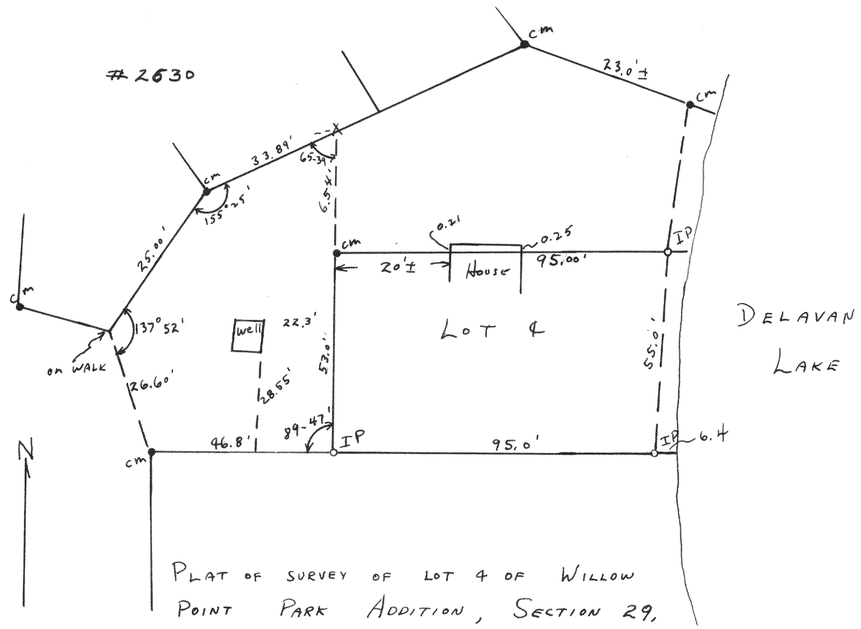


Plat of survey of Lot 4 of Willow Point Park Addition, Section 29, T2N R16E.

Aug 7, 1952

Lloyd L Jensen
County Surveyor CRS.

#2631

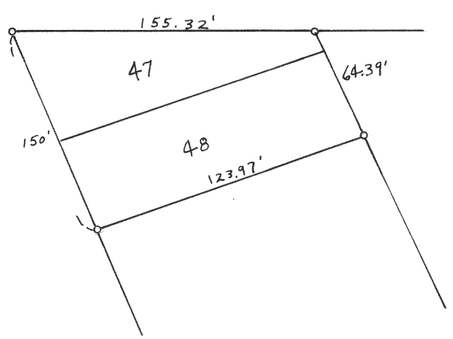


Plat of survey of Lots 47 and 48 of Block 3 of Inlet Oaks Subd. No. 3

June 28, 1952

Lloyd L. Jensen
County Surveyor CRL

#2632

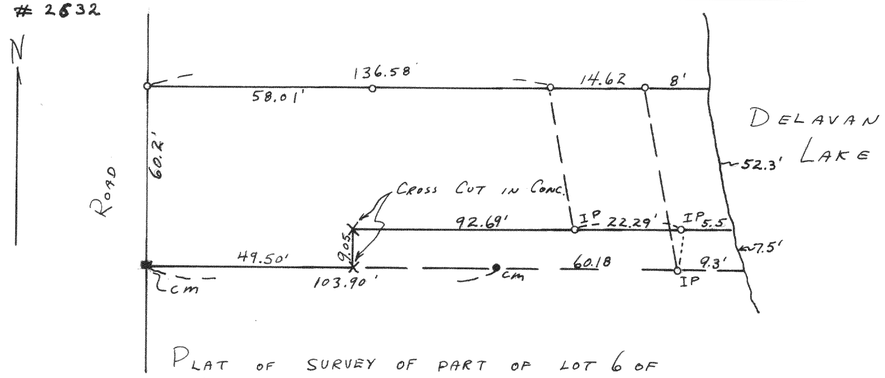

Plat of survey of part of Lot 6 of Willow Point Park Addition, Section 29, T2N R16E.

May 31, 1952

Lloyd L Jensen
County Surveyor CRS