

2831

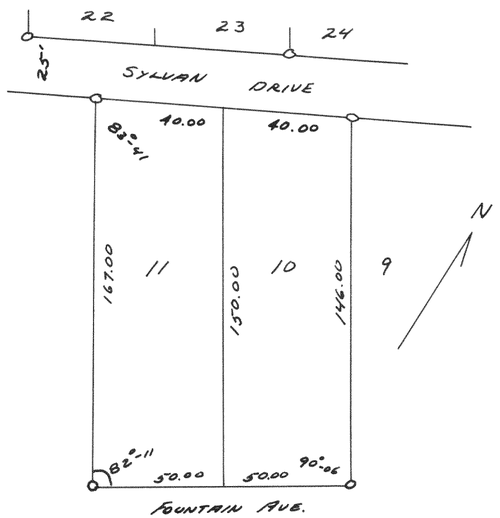


PLAT OF SURVEY OF LOTS 10 & 11 BUENA VISTA VILLAGE OF FONTANA ON GENEVA LAKE LLJ CS
JUNE 1953

2832

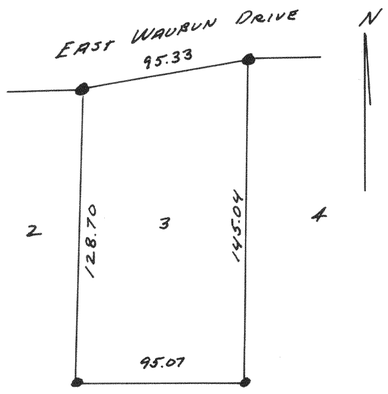


PLAT OF SURVEY OF LOT 3 BLOCK H UNIT 3 COUNTRY CLUB ESTATES VILLAGE OF FONTANA ON GENEVA LAKE LLJ CS
SEPT. 1953

2833

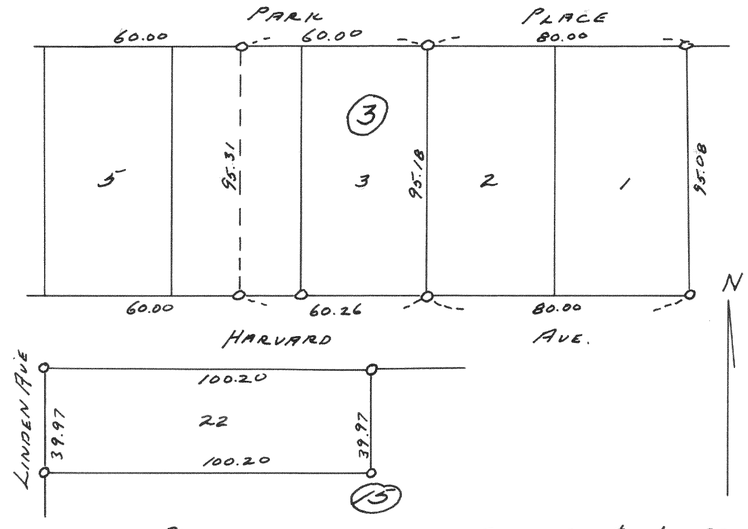


PLAT OF SURVEY OF BLOCK 3 & LOT 22 OF BLOCK 15 GLENWOOD SPRINGS SUBDIVISION VILLAGE OF FONTANA-ON-GENEVA LAKE LLJ CS
JULY 1953

2834

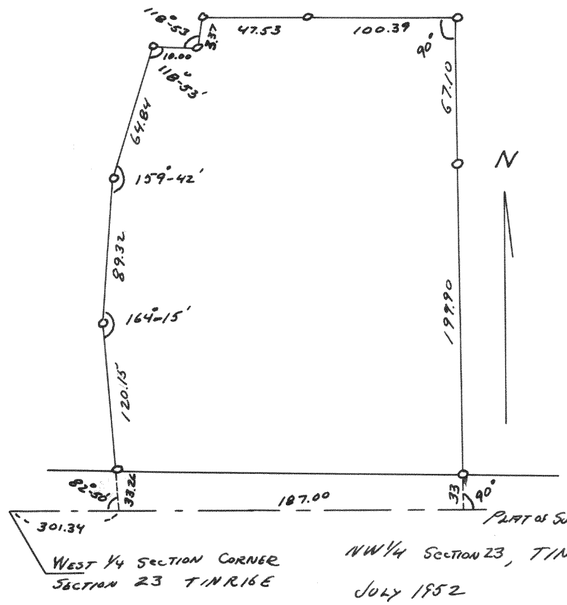


PLAT OF SURVEY OF LAND IN NW1/4 SECTION 23, T1NR16E VILLAGE OF FONTANA LLJ CS
JULY 1952

2835

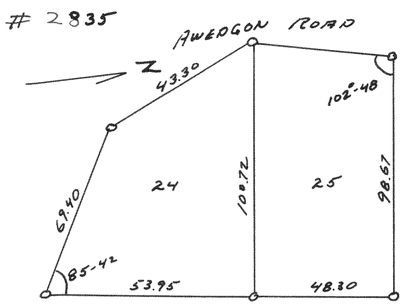

PLAT OF SURVEY OF LOTS 24 & 25 BLOCK 6 INDIAN HILLS VILLAGE OF FONTANA ON GENEVA LAKE LLJ CS
1953

2836

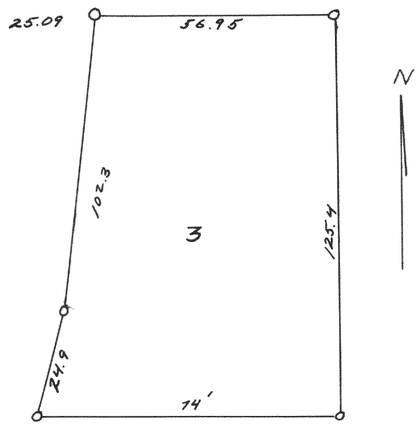

PLAT OF SURVEY OF LOT 3 BLOCK 6 INDIAN HILLS SUR VILLAGE OF FONTANA ON GENEVA LAKE LLJ CS
1953