
506

#4321

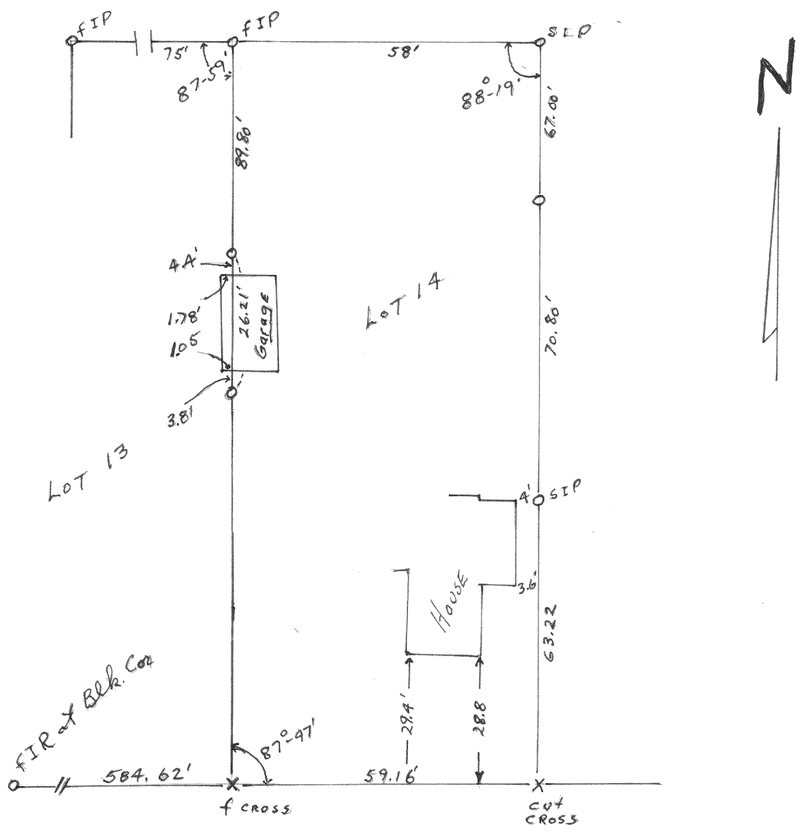


Seymour St.

Plat of survey of Lot 14 Block 4 of Citizens Addition to Village of Sharon.

Sept. 1962

Floyd L Jensen
County Surveyor

#4322

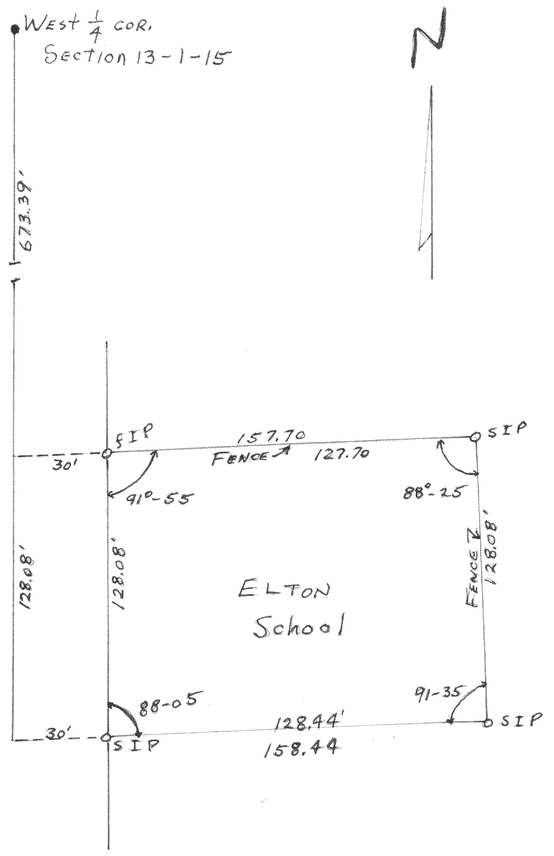

Plat of survey of land owned by Elton School in the NE 1/4 of Section 13, T1N R1E

Oct. 8, 1964

Floyd L Jensen
County Surveyor