
#4323

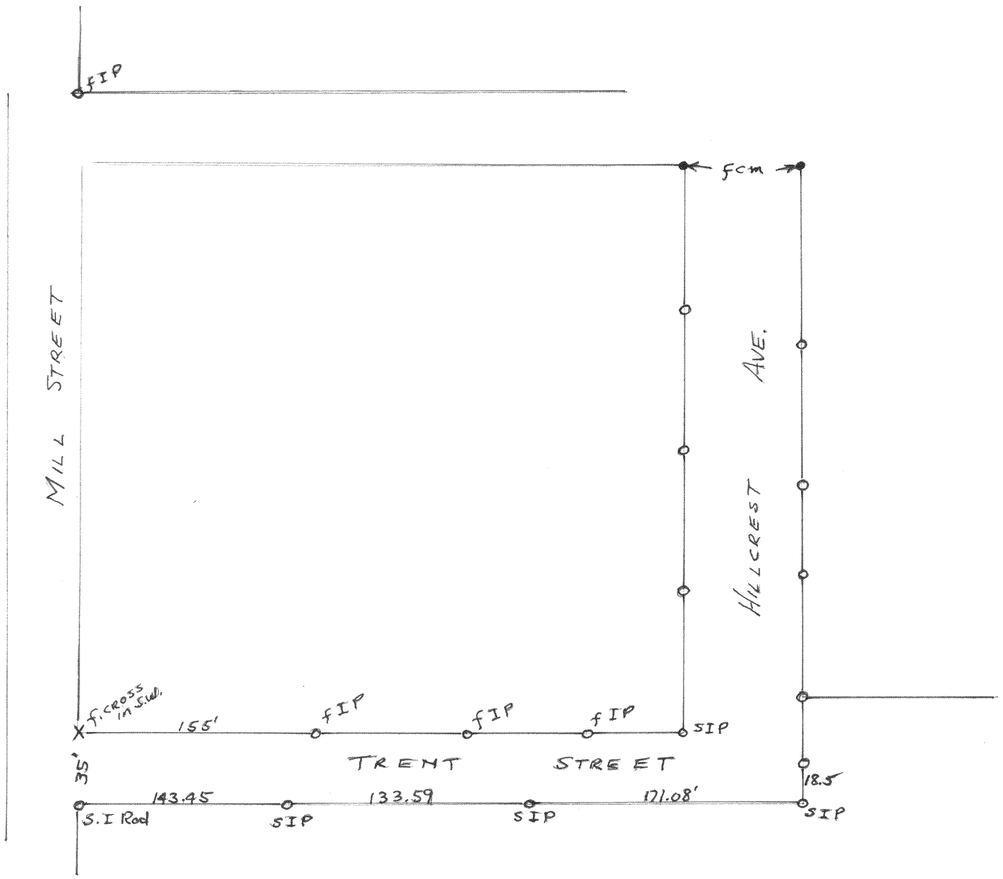


Plat of Survey of TRENT STREET in the Village of East Troy

Sept. 11, 1950

Floyd L Jensen
County Surveyor

#4324

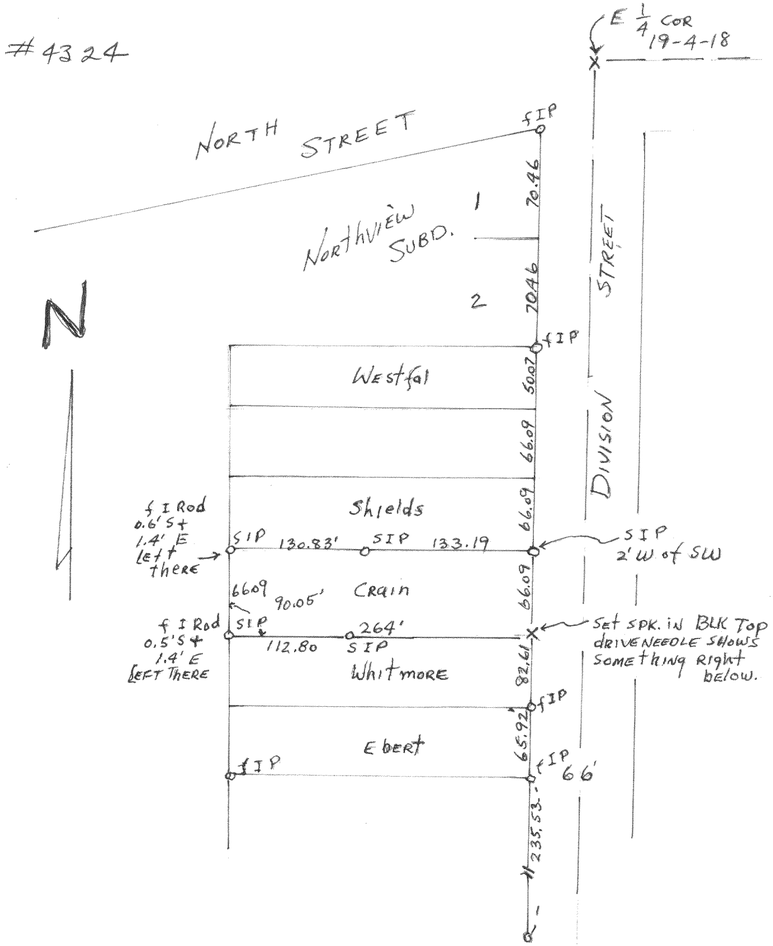

Plat of SURVEY of a lot on DIVISION St. in SEC. 19-4-18.

Nov. 2, 1956

Floyd L Jensen
County Surveyor