
#4325

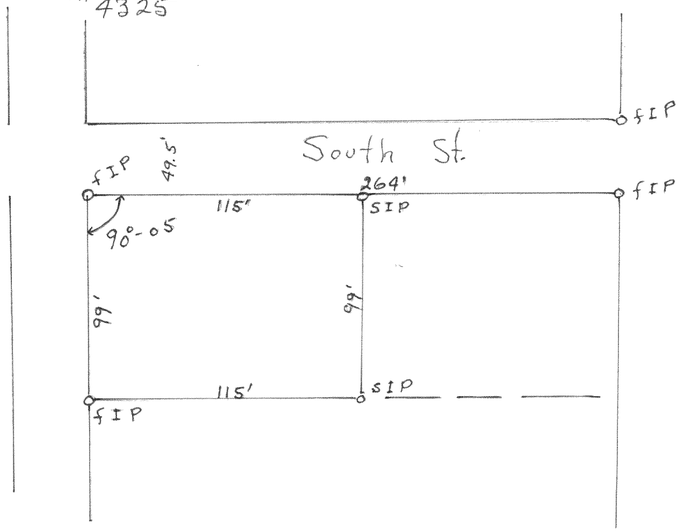



Plat of Survey of part of Lot 1
Blk 18 of original plat of
East Troy

Floyd L Jensen

July 2, 1957 County Surveyor

#4326

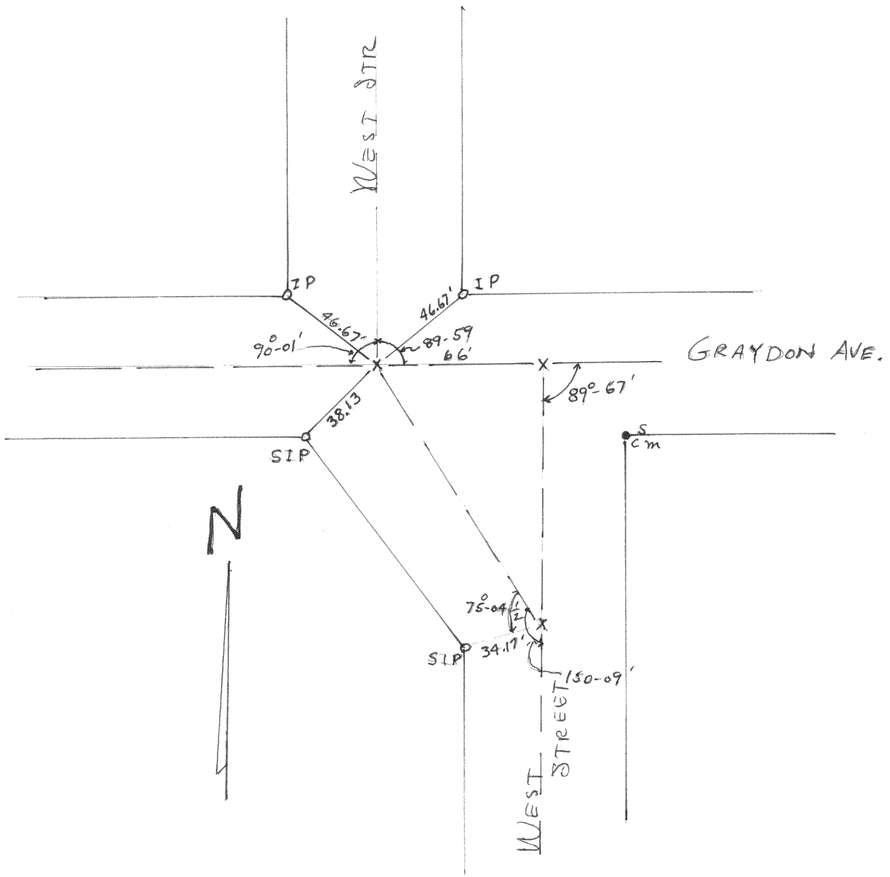


Plat of survey of the intersection
of Graydon Ave and West St.
in the Village of East Troy, Wis

July 1962

Floyd L Jensen

County Surveyor