

# 2837

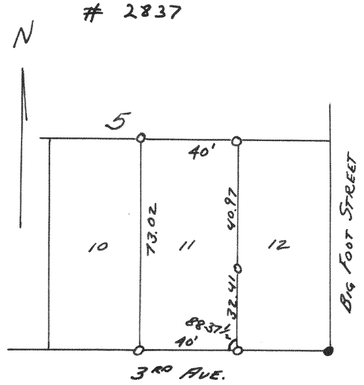


PLAT OF SURVEY OF LOT 11 BLOCK 5
OF D.A. REIDS ADD'N TO REIDS PARK
VILLAGE OF FONTANA ON GENEVA LAKE
1953 LLJ CS

# 2838

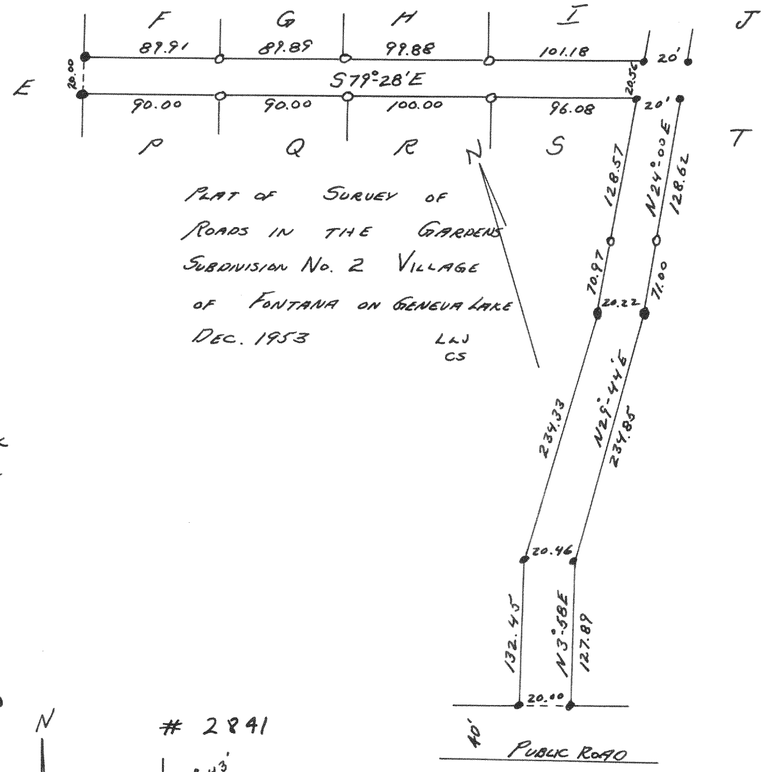



PLAT OF SURVEY OF
ROADS IN THE GARDENS
SUBDIVISION No. 2 VILLAGE
OF FONTANA ON GENEVA LAKE
DEC. 1953 LLJ CS

# 2839


ADDITION "D" TO COUNTRY CLUB ESTATES
VILLAGE OF FONTANA ON GENEVA LAKE
AS RECORDED ON PAGE ___ VOLUME ___
OF PLATS WALWORTH COUNTY RECORDS

# 2840

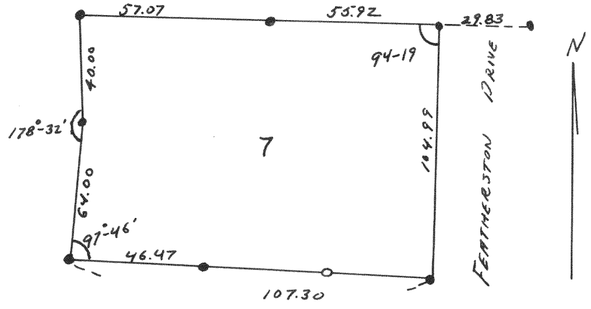



PLAT of SURVEY OF LOT 7 BLOCK F UNIT 3
COUNTRY CLUB ESTATES VILLAGE OF FONTANA ON GENEVA LAKE
SEPT 1953 LLJ CS

# 2841

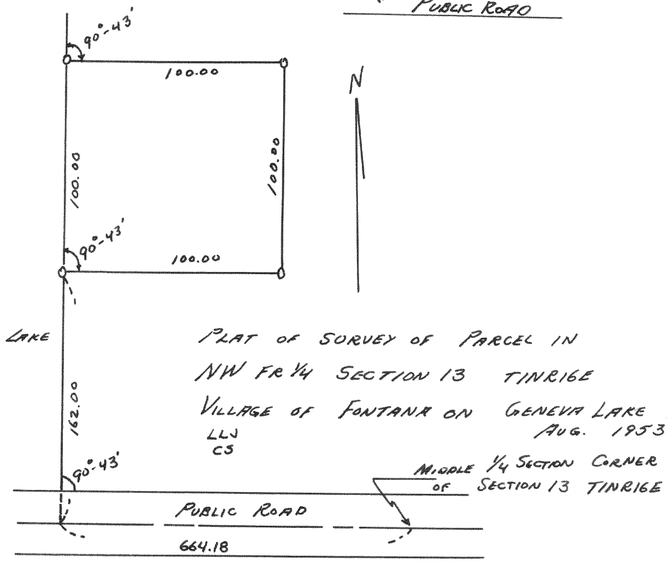


PLAT OF SURVEY OF PARCEL IN
NW FR ¼ SECTION 13 T1NR16E
VILLAGE OF FONTANA ON GENEVA LAKE
LLJ CS AUG. 1953

# 2842

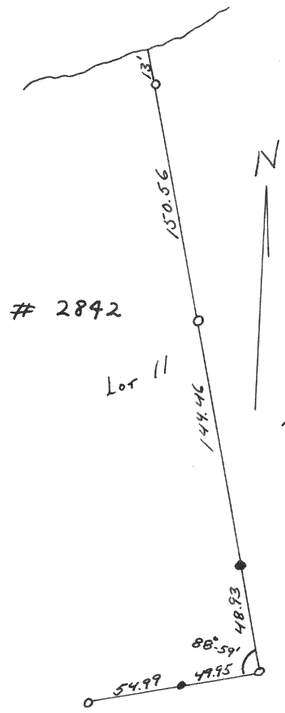


PLAT OF SURVEY OF EAST LINE
LOT 11 UNRECORDED BIRCHES
IN SECTION 9 T1NR17E
SEPT 1953 LLJ CS