

#4329

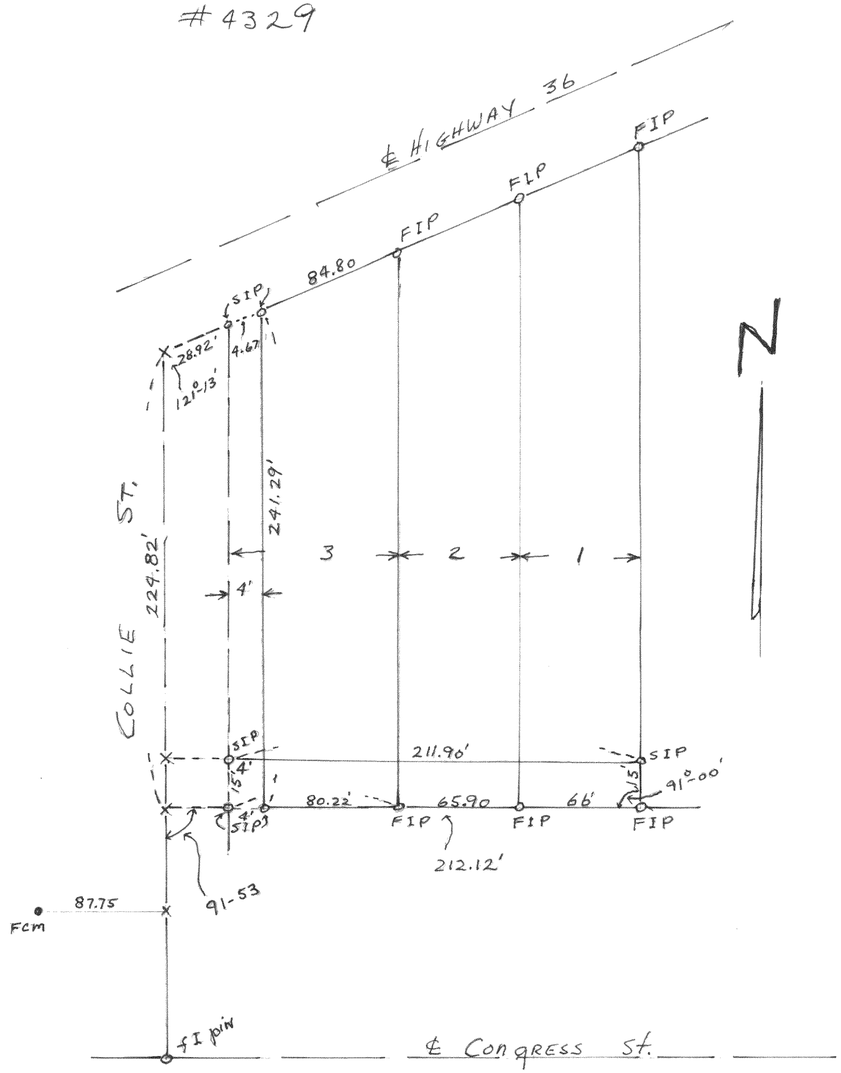

Survey to mark the South 15 feet of Lots 1, 2 & 3 of Dodge Subd. in Wms Bay Wis. for a storm SEWER EASEMENT.
DEC. 1964

Floyd L Jensen
County Surveyor

#4330

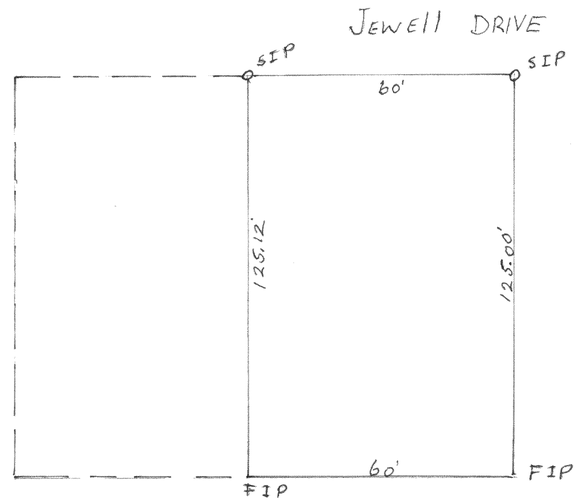

Plat of SURVEY of Lot 15 of LACKEY BROTHERS Subd in the Village of Wms BAY Wis.
JAN. 15, 1965

Floyd L Jensen
County Surveyor