
#2849

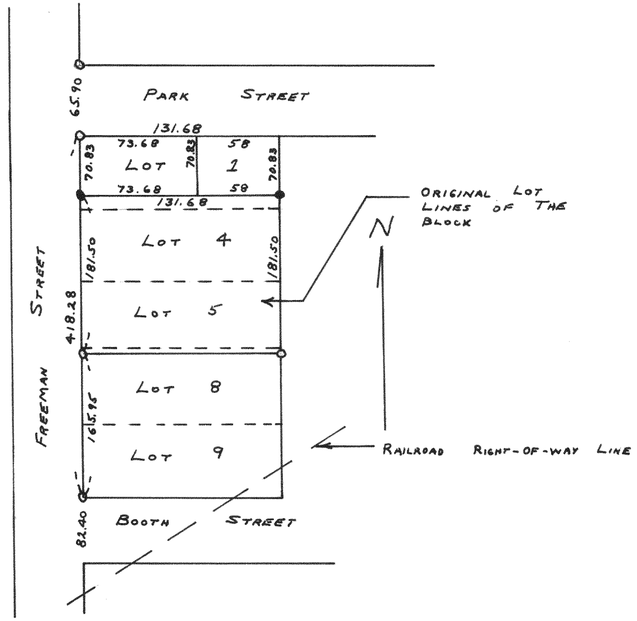


PLAT OF SURVEY OF LOTS 1, 4 AND 5 OF FREEMAN'S ADDITION IN THE VILLAGE OF GENOA CITY, WISCONSIN.

JANUARY 1954

LLOYD L. JENSEN SA
COUNTY SURVEYOR

#2851

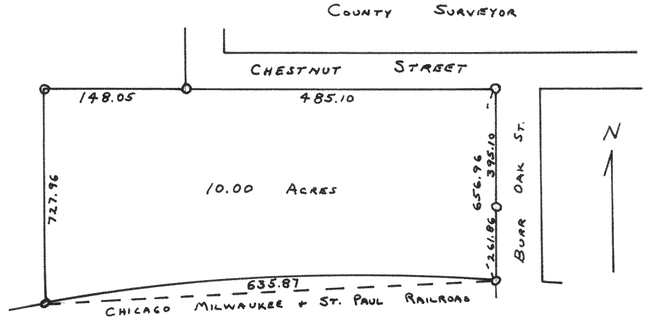


A PARCEL OF LAND LOCATED IN JUSTUS CARPENTER'S ADDITION AND THE SOUTHWEST 1/4 OF SECTION 22, T5N, R16E, VILLAGE OF PALMYRA, JEFFERSON COUNTY, WISCONSIN.

JULY 1954

LLOYD L. JENSEN SA
COUNTY SURVEYOR

#2850

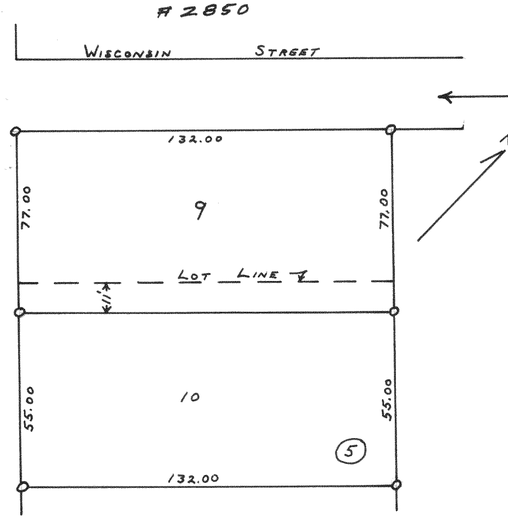


LOTS 9 AND 10, BLOCK 5 OF HIGGINS ADDITION TO THE VILLAGE OF PALMYRA, JEFFERSON COUNTY, WISCONSIN

JULY 1954

LLOYD L. JENSEN SA
COUNTY SURVEYOR

#2852

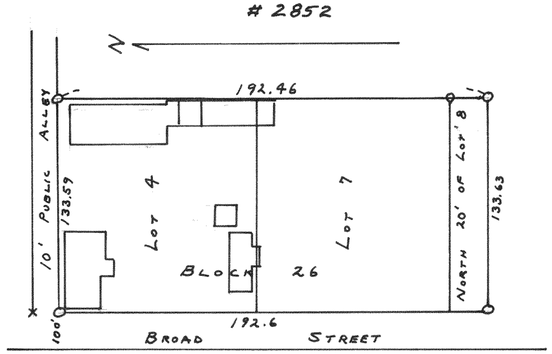


LOTS 4, 7 AND NORTH 20' OF LOT 8 BLOCK 26, ORIGINAL PLAT OF CITY OF ELKHORN WALWORTH COUNTY, WISCONSIN

OCTOBER 1954

LLOYD L. JENSEN SA
COUNTY SURVEYOR

#2853

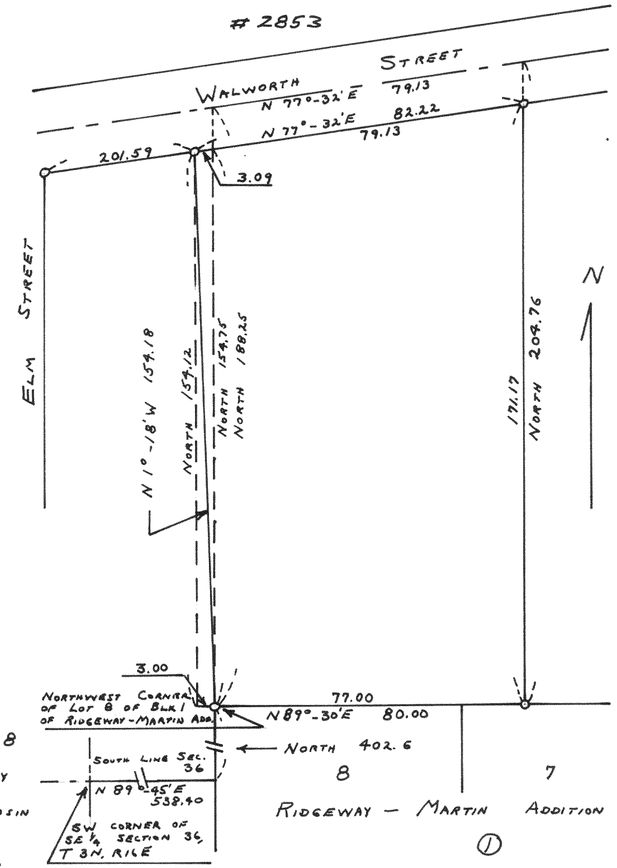

PLAT OF SURVEY OF LAND LOCATED IN THE SE 1/4 OF SECTION 36, T 3N, R16E CITY OF ELKHORN, WALWORTH COUNTY, WISCONSIN.

FEBRUARY 1954

LLOYD L. JENSEN SA
COUNTY SURVEYOR