~~532~~

#4366

PLAT OF SURVEY

OF


LOT 30 LAKE GENEVA HIGHLANDS

SEC 8 & 9 TIN RITE WAL. CO. WIS.

SEPT 1965

Lloyd L Jensen

CO. SURVEYOR

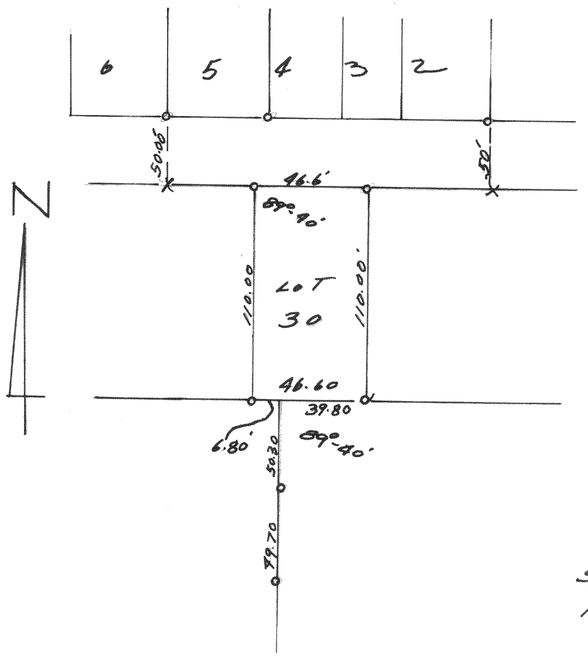

#4367

PLAT OF SURVEY

OF

TEN ACRE PARCEL LOCATED IN THE


SW 1/4 OF SEC 29, TIN RITE WAL. CO. WIS.

AUG 1965

Lloyd L Jensen

Lloyd L. Jensen

Co. SURVEYOR

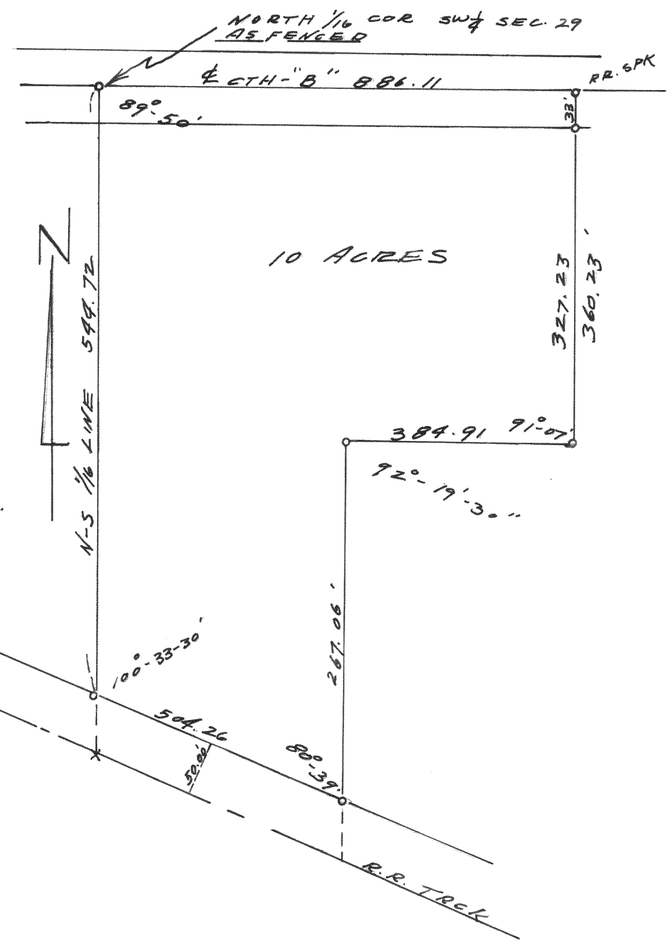

#4368

PLAT OF SURVEY

OF

LOT 44 LAKE GENEVA KNOLL SUBD.

SEC 33, T2N R17E WAL. CO. WIS.

MAY 1965

Lloyd L Jensen

L.L. JENSEN CO. SURVEYOR

