

#4376 PLAT OF SURVEY
OF
LOTS 4746-4753 BLK 83
LAKE COMO BEACH SUBD.
T2N R17E WAL. CO. WIS.
JUNE 1965

Floyd L Jensen
LL JENSEN Co. SURVEYOR

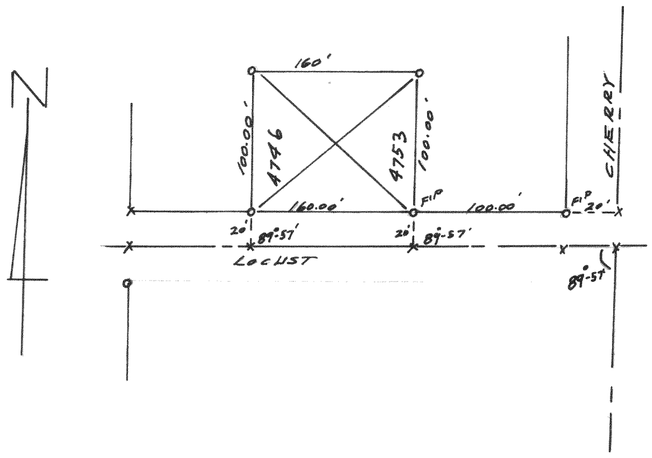

#4377 PLAT OF SURVEY
OF
LAND LOCATED IN THE SW¼ OF
SEC 19 T3N R17E WAL. CO. WIS.
JUNE 1965

Floyd L Jensen
CO. SURVEYOR

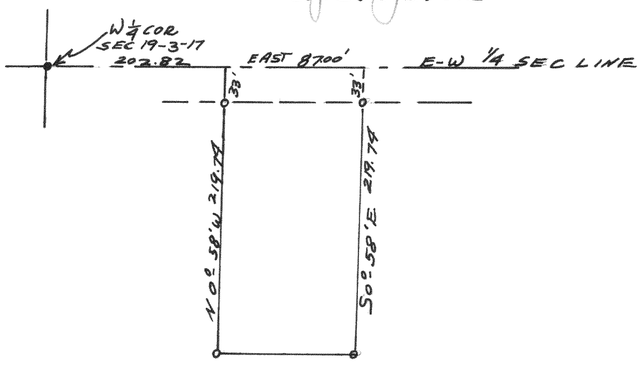

#4378 PLAT OF SURVEY
OF
A PARCEL IN THE SE¼ OF
SECTION 12 & THE NE¼ OF
SECTION 13, T4N R17E
WAL CO WIS.

JULY 1965

Floyd L Jensen
Lloyd L. Jensen Co. Surveyor

