
#4384

PLAT OF SURVEY
OF
LOTS 3, 4, & 5. BLOCK 4
MIRAMAR SUBDIVISION IN
SECTIONS 10 & 11, TAN RIBE
WAL. Co. WIS.
AUG 1965

Floyd L Jensen
LLOYD L. JENSEN
CO. SURVEYOR

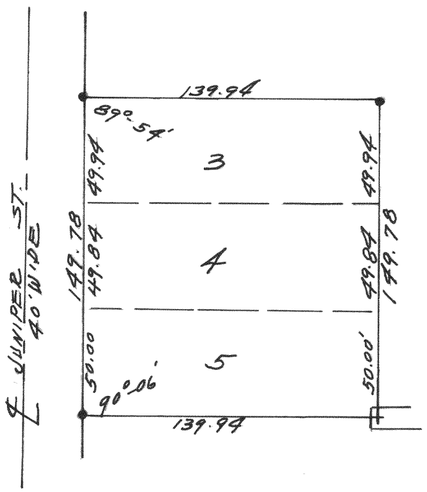

#4385

PLAT OF SURVEY
OF
LOTS 1 + 2 BLK 22 MIRAMAR
SUBD. ADD. #1 IN THE NW¼ SEC 10,
T4N R18E WAL. CO. WIS.

MAY 1965

Floyd L Jensen
Lloyd L. Jensen
CO. SURVEYOR

