#4388

PLAT OF SURVEY
OF
S½ OF LOT 24 + LOTS 25 & 26
OF BOOTH LAKE HEIGHTS SUBD
SEC 13 + 24 T4N R17E WAL. CO. WIS.

JULY 1965

Floyd L Jensen
L.L. JENSEN CO. SURVEYOR

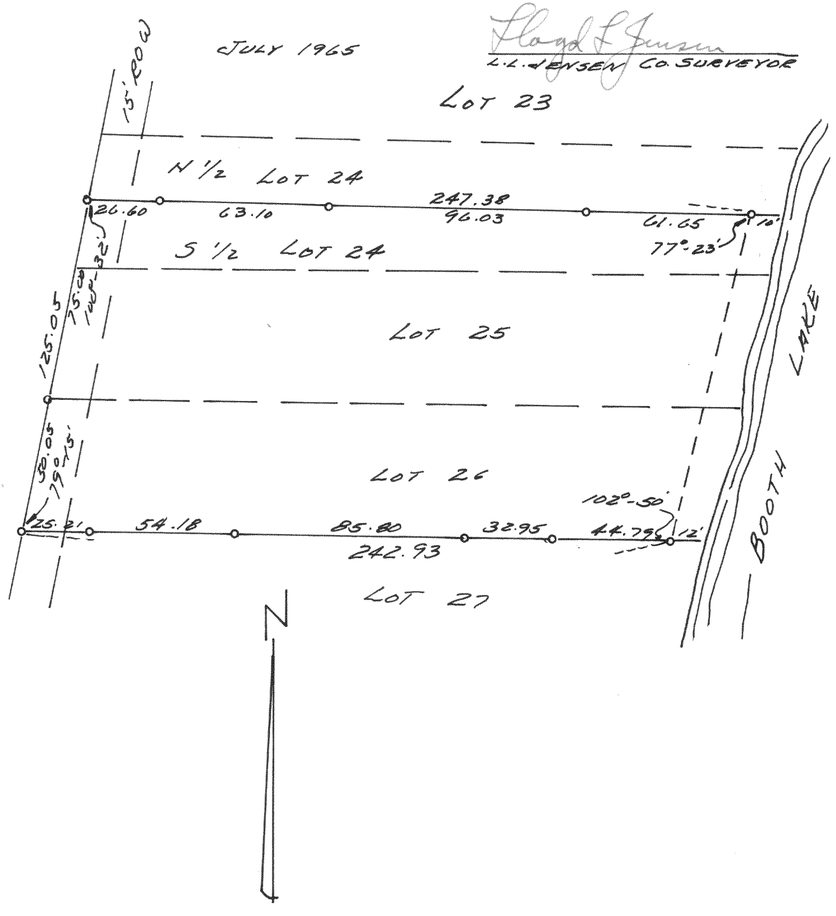

#4389

PLAT OF SURVEY
OF
LAND IN THE SE ¼ OF SECTION 18
T2N R18E WAL Co WISCONSIN

JULY 1965
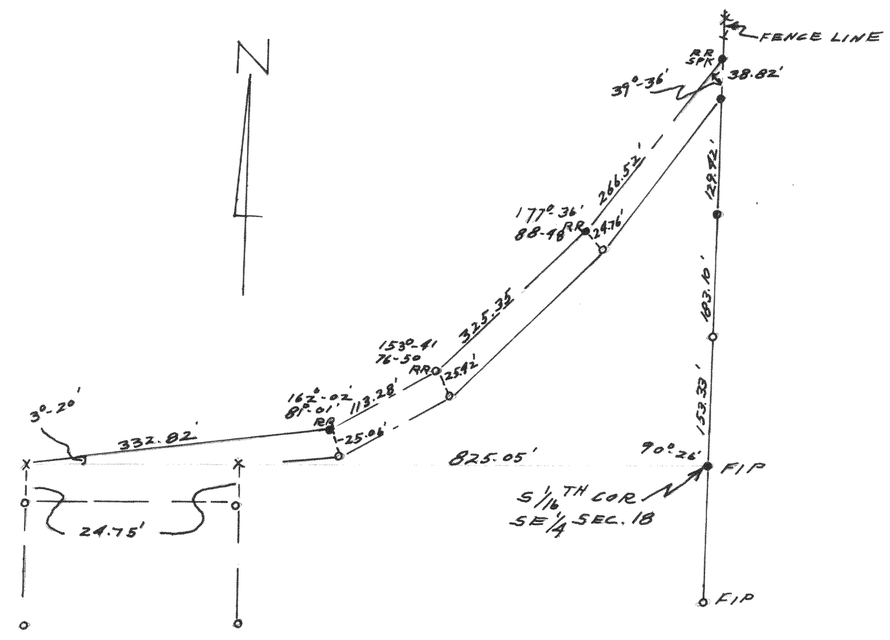
Floyd L Jensen
Lloyd L Jensen Co Surveyor