
#4398

PLAT OF SURVEY

LOTS 7074 - 7075 - 7076 BLOCK 121
LAKE COMO BEACH SUBDIVISION
WALWORTH COUNTY, WISCONSIN.

AUGUST 1965

Floyd L Jensen
CO. SURVEYOR

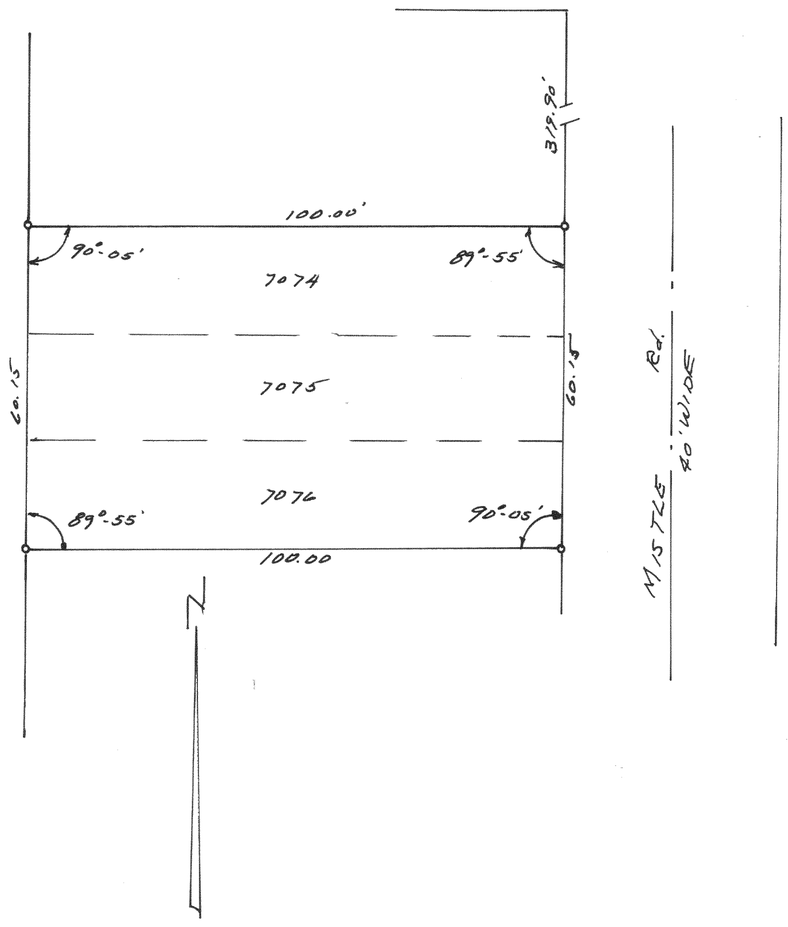

#4399

PLAT OF SURVEY OF

NE 1/4 SECTION 19
T2N - R17E, WALWORTH
COUNTY, WISCONSIN.

DEC. 1965

Floyd L Jensen
CO. SURVEYOR

