#4402 PLAT OF SURVEY

MAY 1965 OF

Floyd L. Jensen
CO. SURVEYOR

LOT 29 BLOCK 1, INDIAN HILLS SUBDIVISION LOCATED IN SECTION 14, T1N, R16E. VILLAGE OF FONTANA, WALWORTH COUNTY, WISCONSIN.

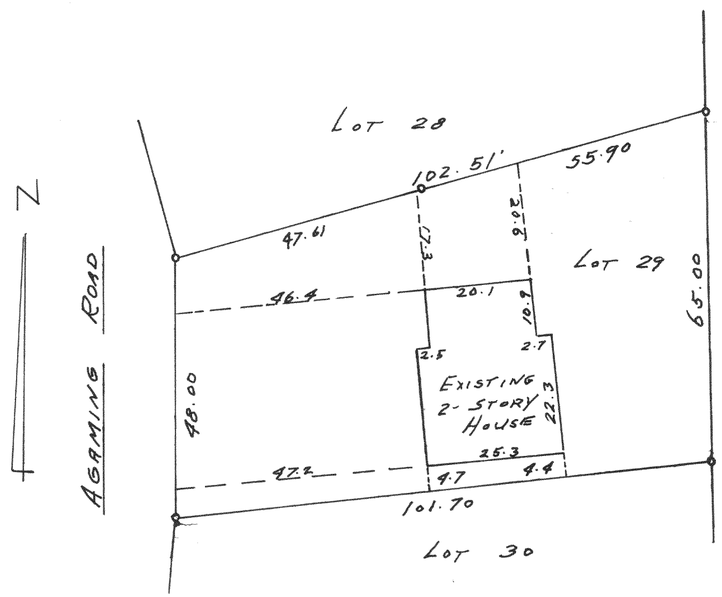

#4403 PLAT OF SURVEY

MAY 1965 OF

Floyd L. Jensen
CO. SURVEYOR
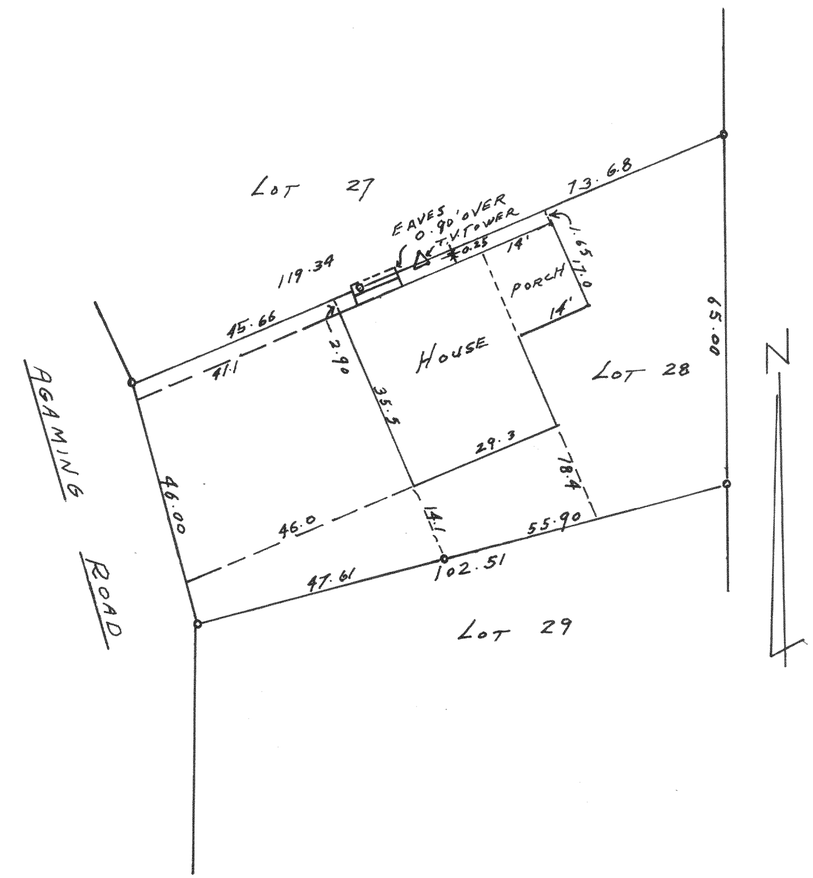
LOT 28 BLOCK 1, INDIAN HILLS SUBDIVISION LOCATED IN SECTION 14, T1N, R16E VILLAGE OF FONTANA, WALWORTH COUNTY, WISCONSIN.