

#2857

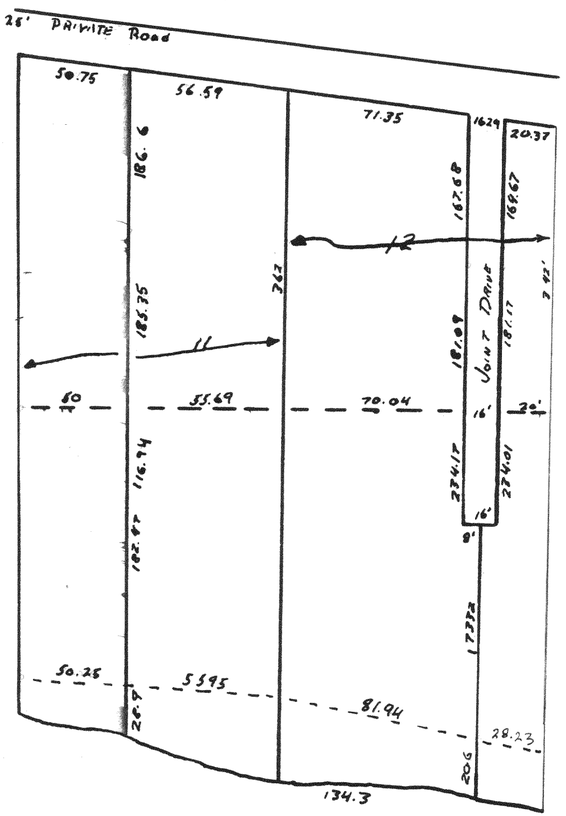

PLAT OF SURVEY OF LOTS 11 EXCEPT WEST 50 AND LOT 12 EXCEPT EAST 28 ft OF L. 8 CHYSIN Subd TIN R17E WALWORTH COUNTY WISCONSIN


APRIL 1954 Lloyd L JENSEN

#2858

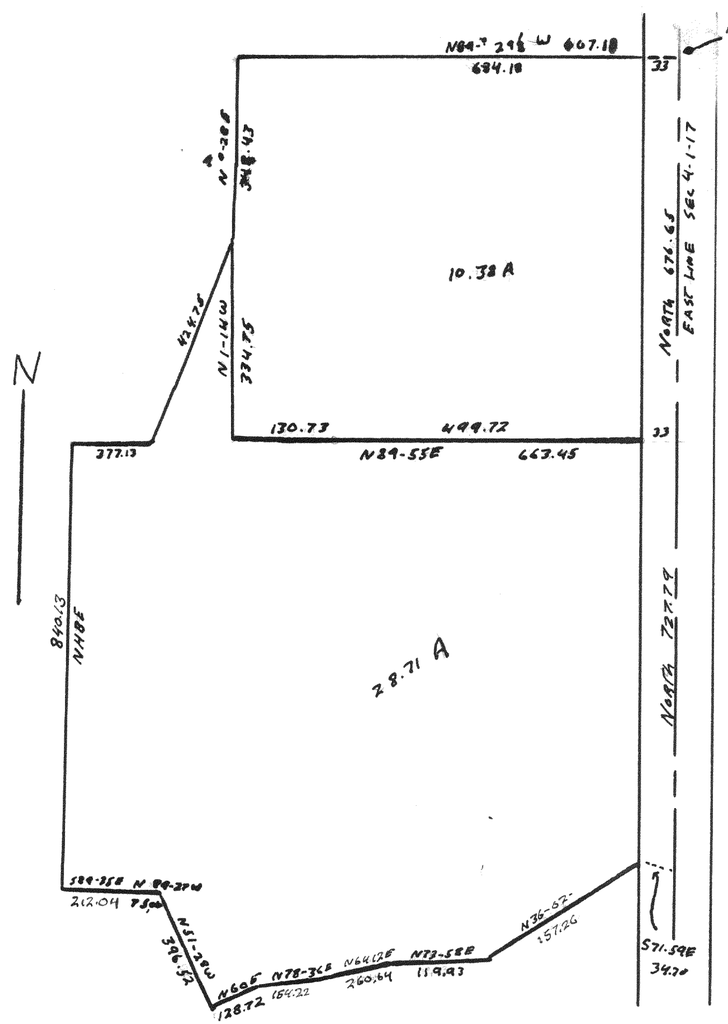


PLAT OF SURVEY OF LAND IN NE¼ OF FR SECTION 4 TIN R17E WALWORTH COUNTY WISCONSIN DEC 1954 LLJ CS

#2859

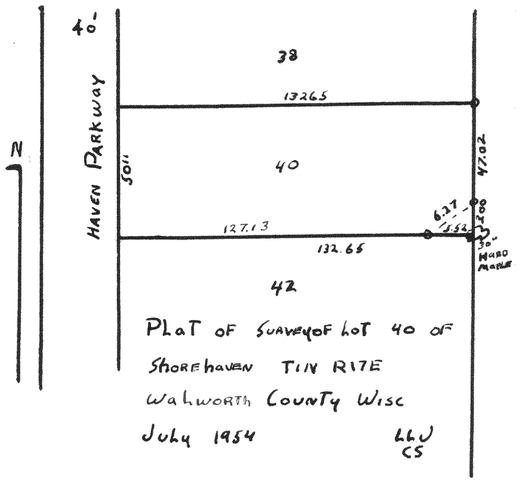

PLAT OF SURVEY OF LOT 40 OF SHOREHAVEN TIN R17E WALWORTH COUNTY WISC JULY 1954 LLJ CS

#2860

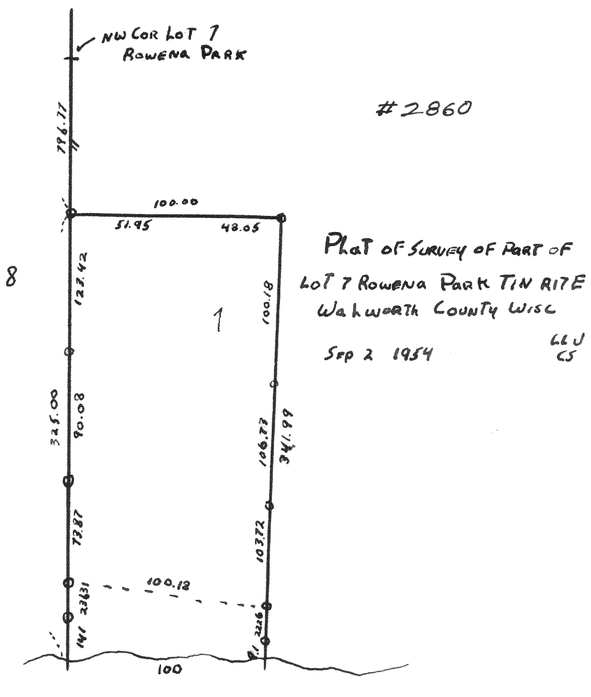

PLAT OF SURVEY OF PART OF LOT 7 ROWENA PARK TIN R17E WALWORTH COUNTY WISC SEP 2 1954 LLJ CS