
page 552

~~A~~ 4406

SEPT. 1965

Floyd L. Jensen
Co. SURVEYOR

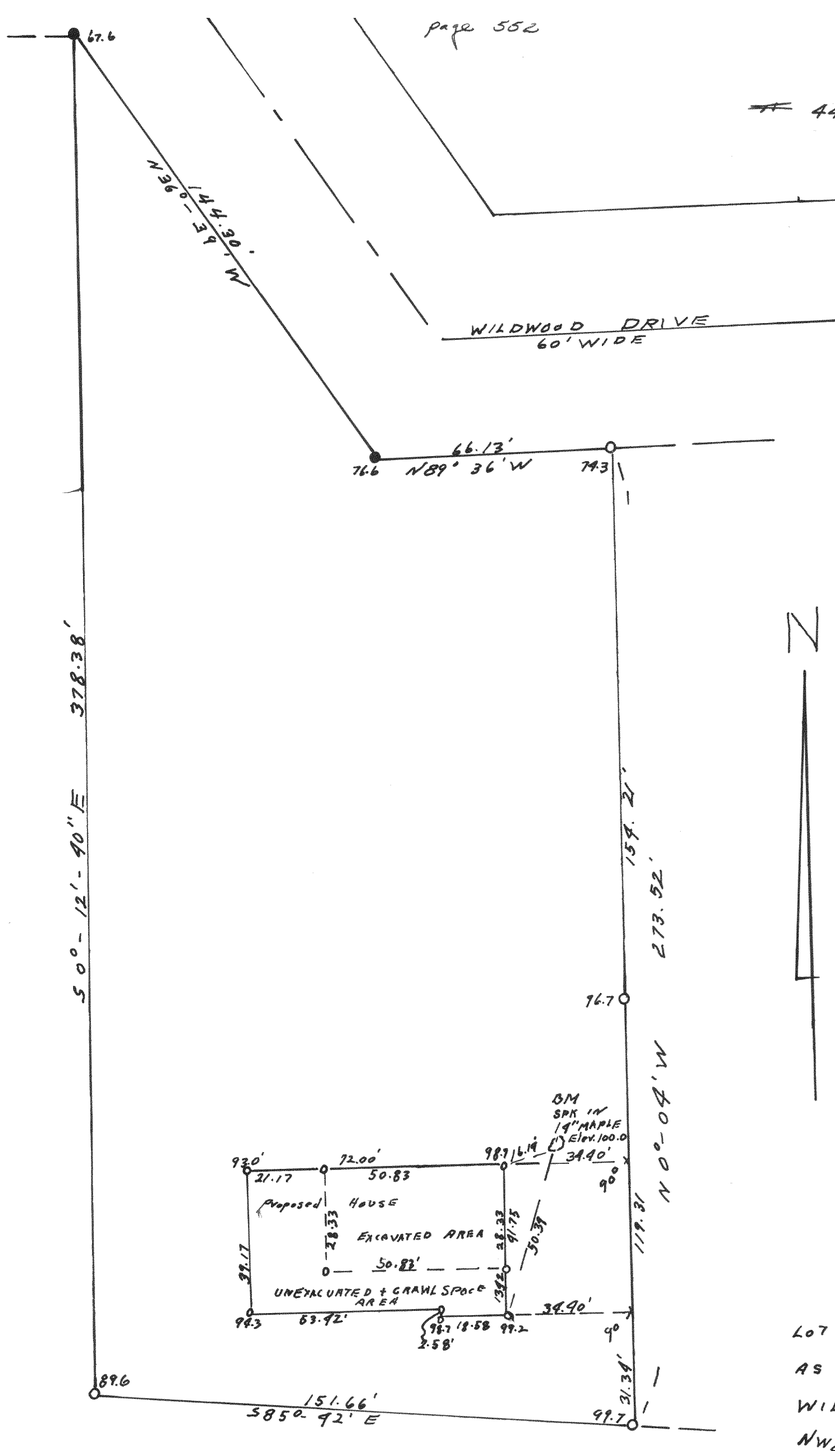

PLAT OF SURVEY

OF

LOT #7 OF THE PRELIMINARY PLAT (TO BE KNOWN AS LOT #4 OF THE FINAL PLAT) OF WILDWOOD SUBDIVISION, LOCATED IN THE NW¼ & NE¼ SEC. 34 T2N R17E WAL. CO. WIS.