

#2861

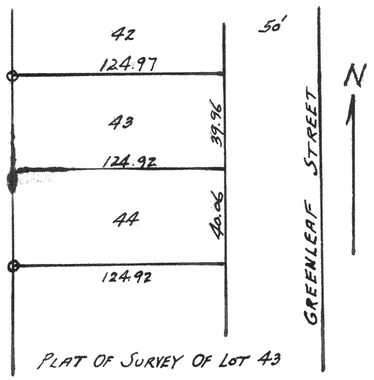


PLAT OF SURVEY OF LOT 43
BLOCK 1 CISCO BEACH
T1NR17E WALWORTH CO. WISC.
SEPT. 1954 LLOYD L. JENSEN
COUNTY SURVEYOR


#2862

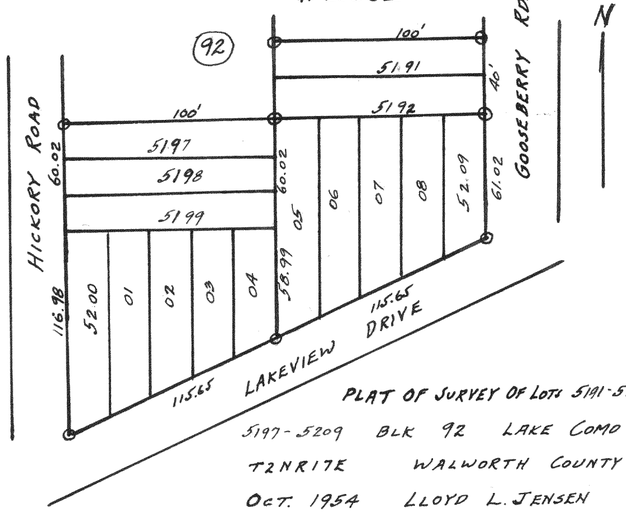

PLAT OF SURVEY OF LOTS 5191-5192
5197-5209 BLK 92 LAKE COMO BEACH
T2NR17E WALWORTH COUNTY WISC.
OCT. 1954 LLOYD L. JENSEN
COUNTY SURVEYOR

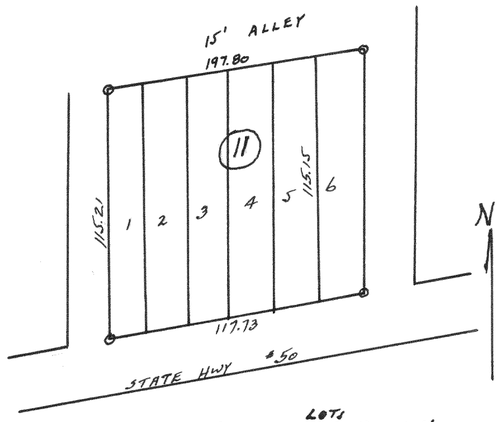

PLAT OF SURVEY OF LOTS 1-5 BLOCK 11
SUNSET HILLS T2NR17E
WALWORTH COUNTY WISCONSIN
JULY 1954
#2863

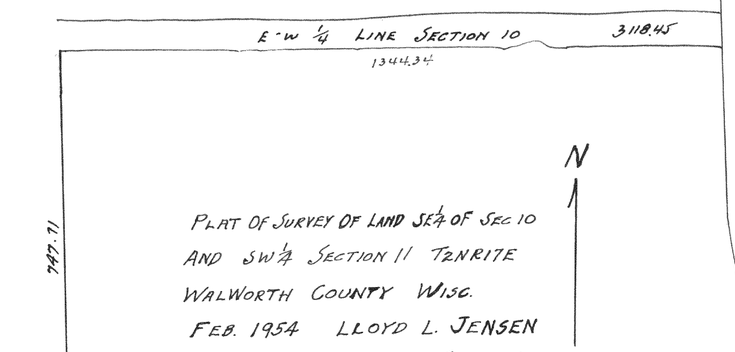

PLAT OF SURVEY OF LAND SE¼ OF SEC 10
AND SW¼ SECTION 11 T2NR17E
WALWORTH COUNTY WISC.
FEB. 1954 LLOYD L. JENSEN
COUNTY SURVEYOR

#2864

