
564

#4418

PLAT OF SURVEY
OF
LAND IN THE E½ - NE¼
SEC. 30, T4N R18E, WAL CO.
WIS.
Oct 1965

Floyd F. Jensen
F. F. Jensen
CO. SURVEYOR

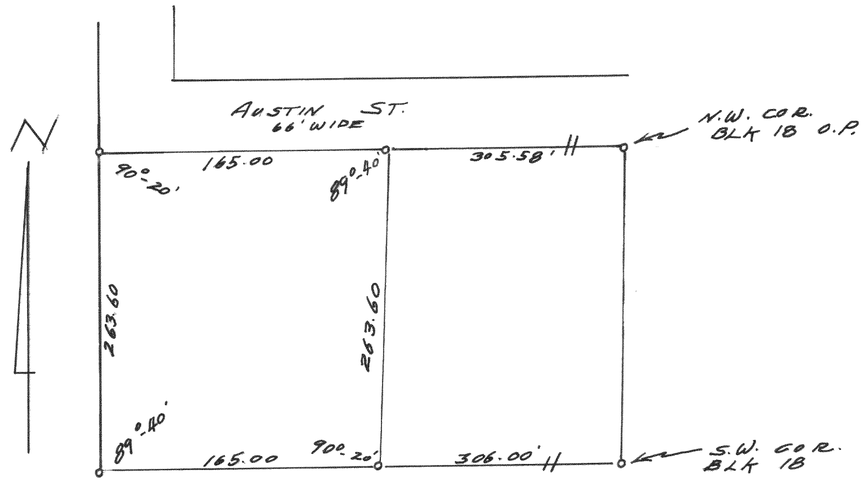

#4419

PLAT OF SURVEY
OF
PART OF LOT 3 ~~BLK 5~~ BLK 6 OF THE
ORIGINAL PLAT OF ELKHORN,
WAL. CO. WIS.
JUNE 1965

Floyd F. Jensen
CO. SURVEYOR

