

4423

PLAT OF SURVEY
OF
LOT 59 WESTPARK SECOND ADDITION
LOCATED IN THE SW¼ OF SECTION 5, TAN-
RISE CITY OF WHITEWATER WAL. CO. WIS.
MAY 1965

Lloyd L Jensen
COUNTY SURVEYOR

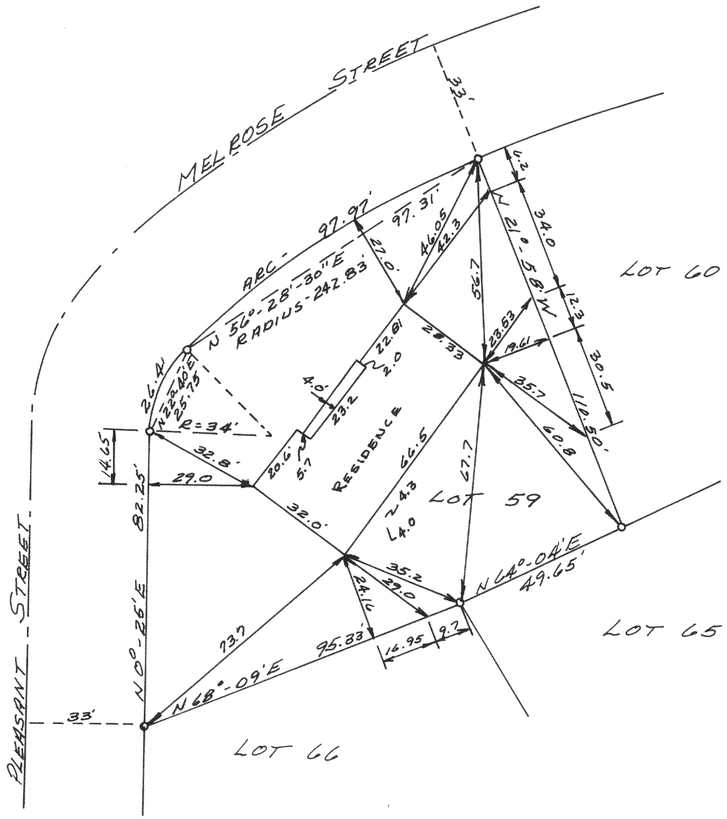

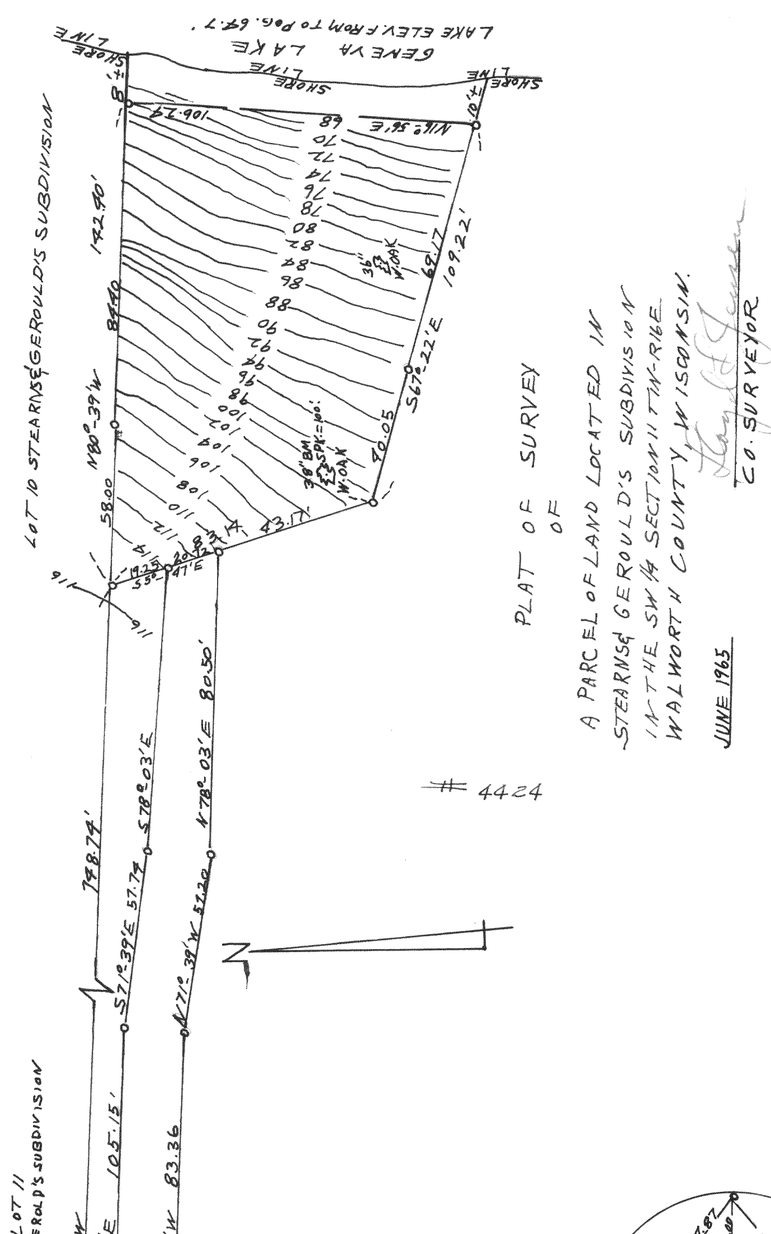

4424