#2865

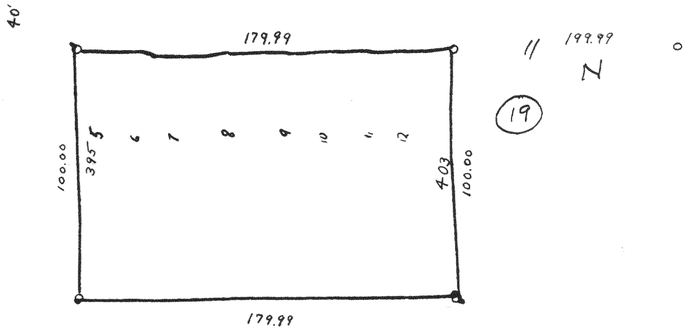

Plat of Survey of Lots 395 - 403 Block 19
Pell Lake Highlands, T1N R18E
March 1954 Lloyd L. Jensen

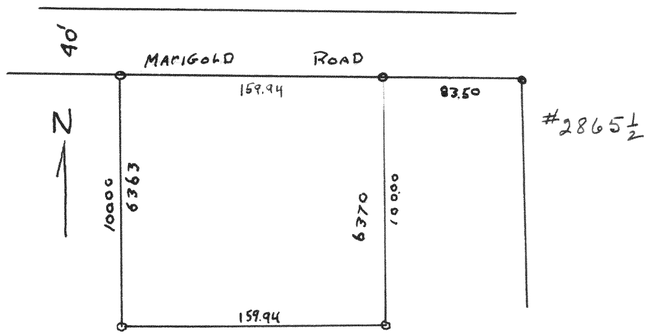

#2866 Plat of Survey of Lots 6363 - 6370 Section 4
Pell Lake T1N R18E Walworth County Wisc.
June 54 Lloyd L. Jensen

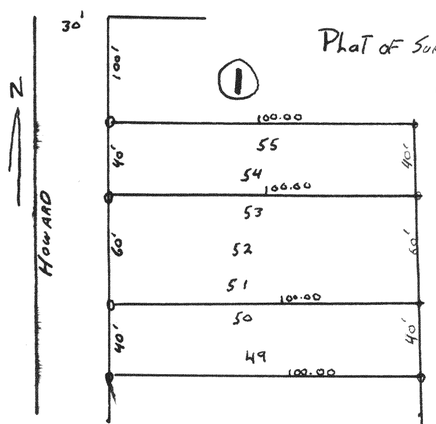

Plat of Survey of Lots 49-56 Block 1
Lake Ivanhoe Resort
T1N R18E Walworth County Wis
July 19.54 Lloyd L. Jesen

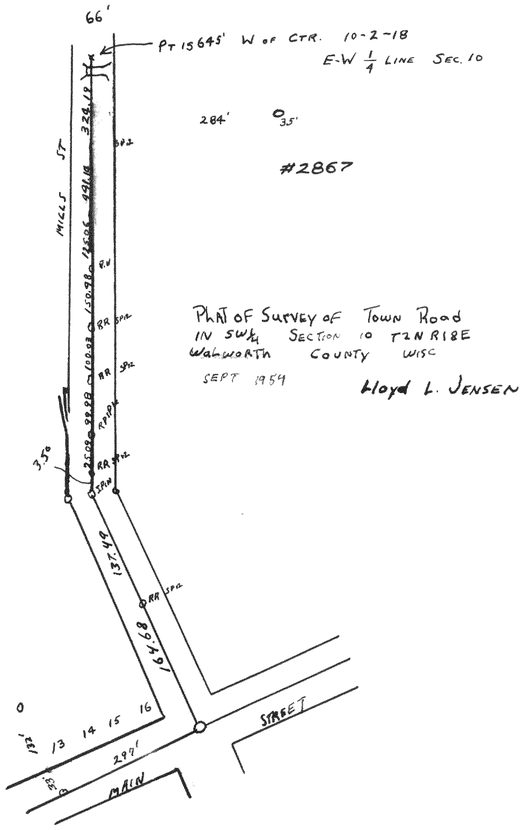

Plat of Survey of Town Road
in SW¼ Section 10 T2N R18E
Walworth County Wisc
Sept 1954 Lloyd L. Jensen

#2868

Plat of Survey of Block 14 Springfield
T2N R18E Walworth County Wisconsin
1954 Lloyd L. Jensen

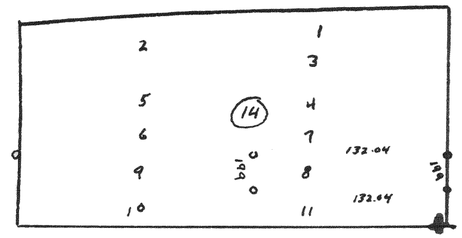

#2869
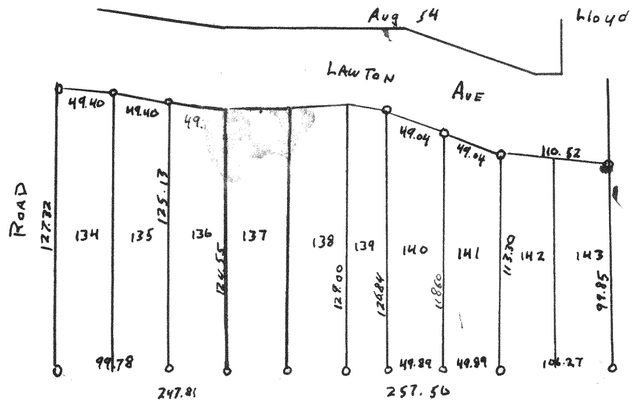
Plat of Survey of Lots 134-143 Golf Hills
T2N R18E Walworth County Wisc.
Aug 54 Lloyd L. Jensen