
570


#4427

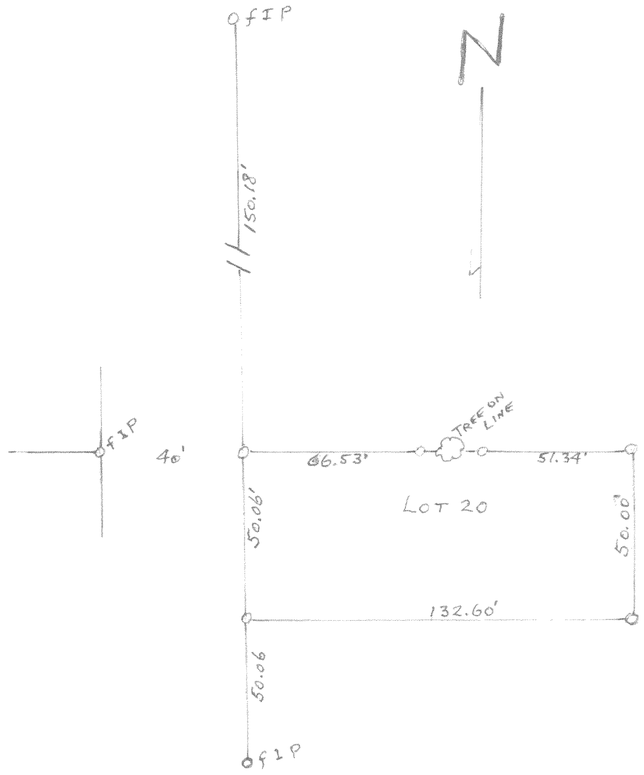

Plat of Survey of Lot 20 of Shore Haven Subd. located in Section 18 T1N R17E.

July 1964 Floyd E Jenn
County Surveyor

#4428

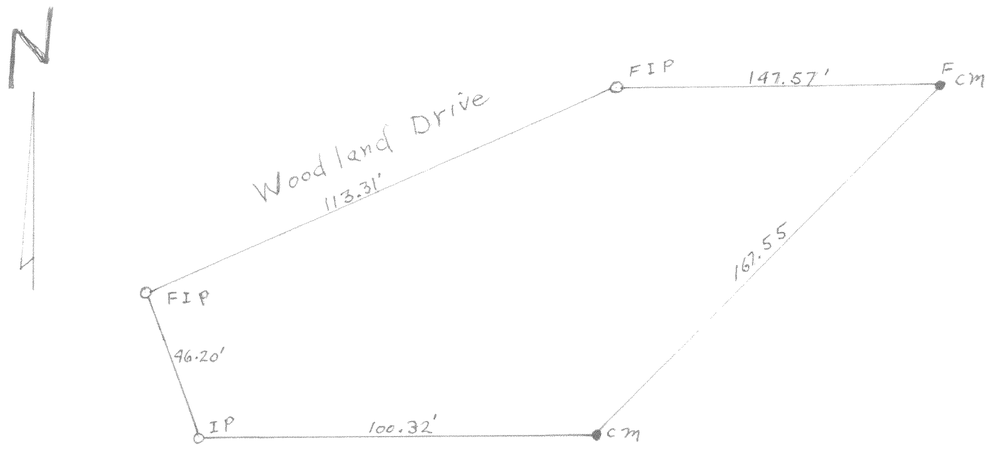

Plat of Survey of Lot 25 Addition E. to Country Club Estates, Fontana, Wis.

June 19, 1962 Floyd E Jenn
County Surveyor