514

#4432

PLAT OF SURVEY OF
LOT 1 OF BLOCK 3 LOCKWOOD PARK
SUBDIVISION, LOCATED IN SECTION
35 T4N, R18E OF WALWORTH
COUNTY, WISCONSIN
MAY, 1964


Lloyd E. Timm
COUNTY SURVEYOR



#4433

PLAT OF LAND FOR
A PARCEL OF LAND LOCATED
IN THE N½ SEC 13, T1N R18E
VILLAGE OF FONTANA, WAL.
CO. WIS
MAR 1964

Lloyd E. Timm
CO. SURVEYOR

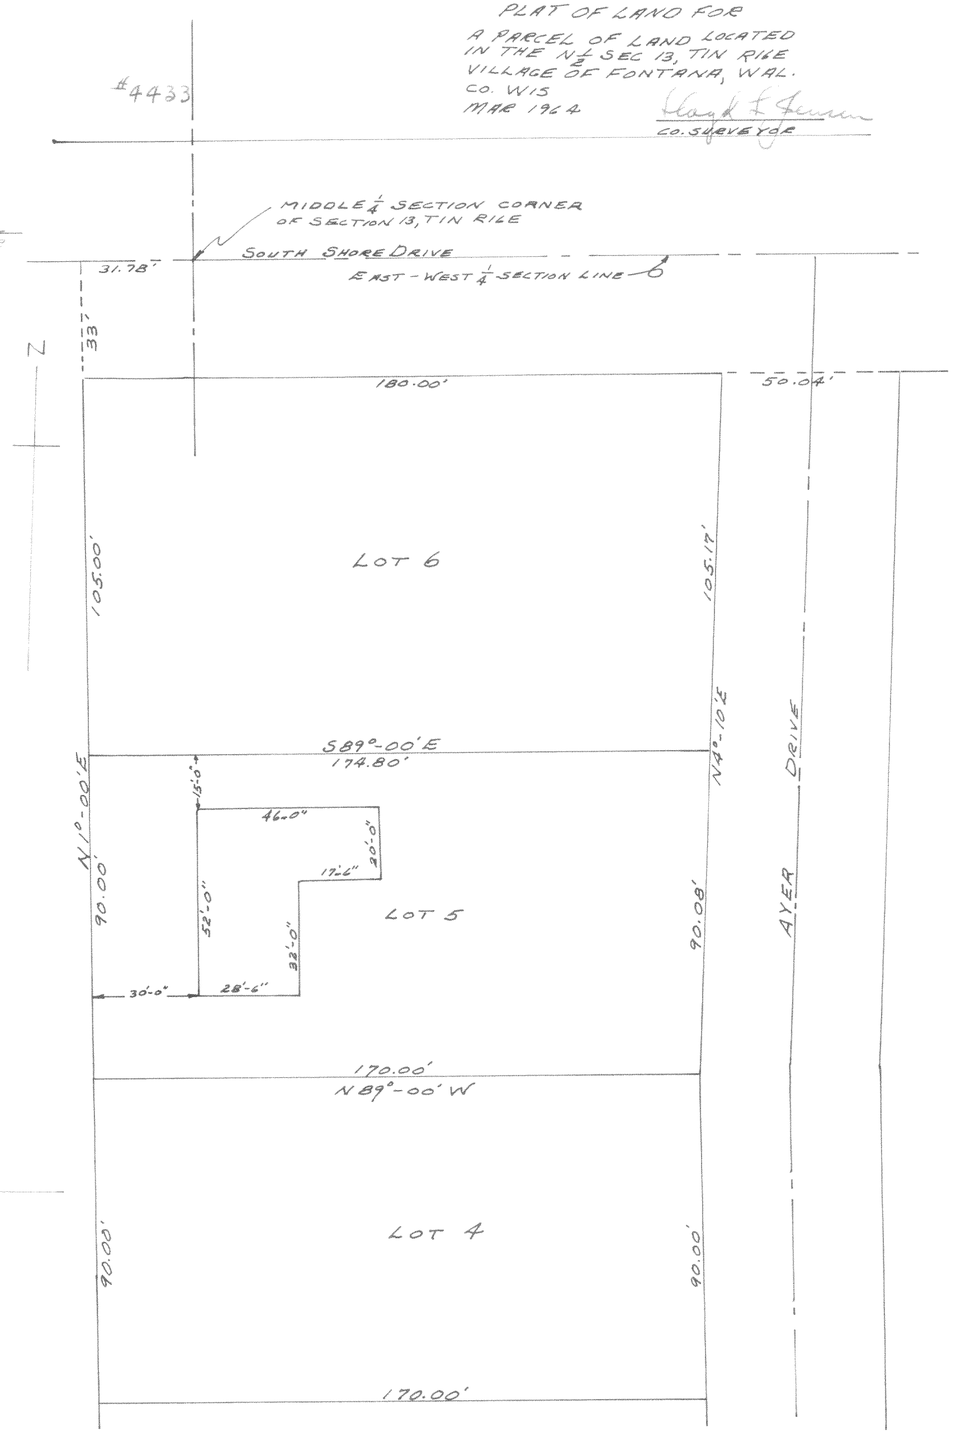

N