
#4434

PLAT OF SURVEY OF
LOTS 6599 TO 6603 OF
LAKE COMO BEACH SUBD.
LOCATED IN WAL. CO. WIS.
SEPT. 1964
Lloyd L Jensen
CO. SURVEYOR

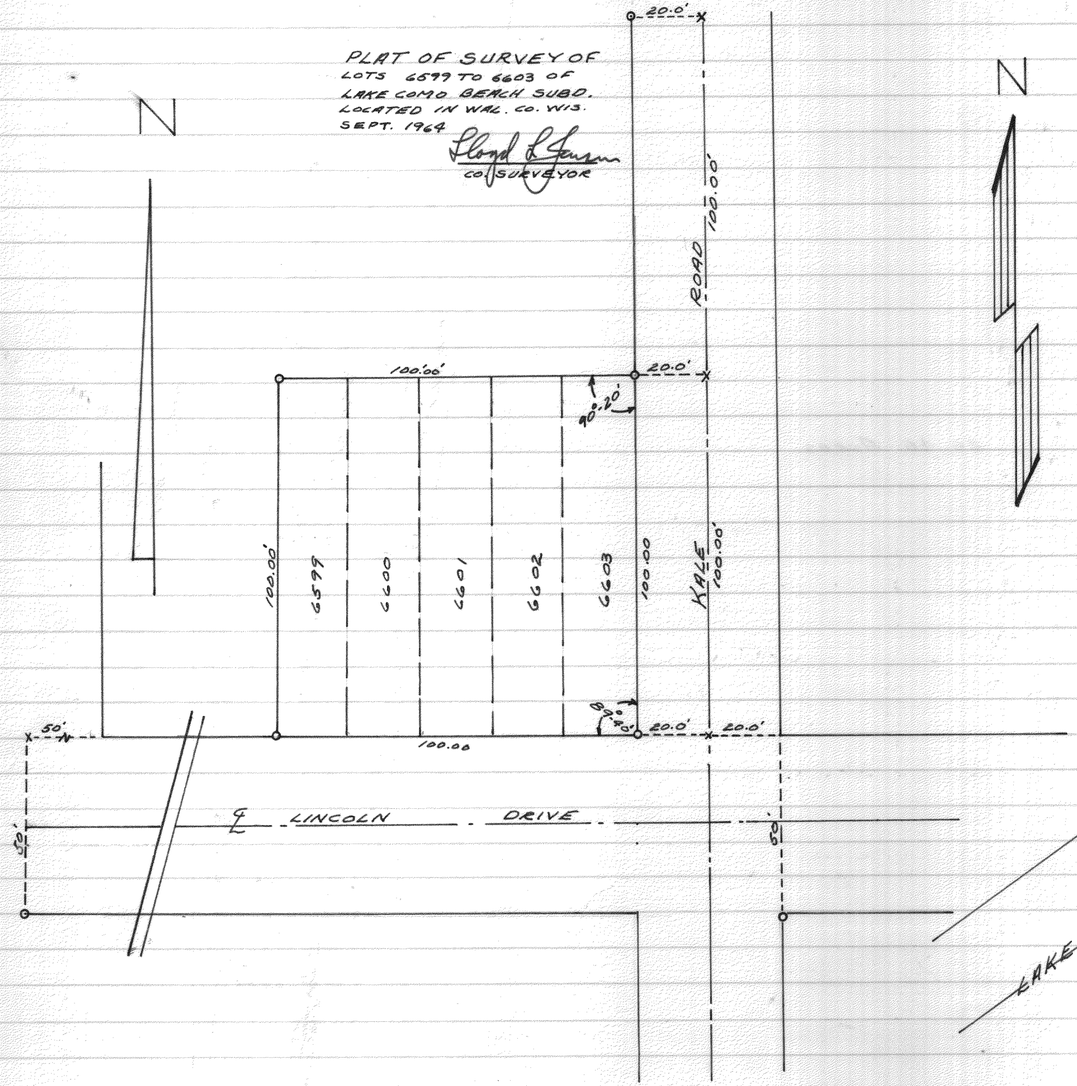

#4435

PLAT OF SURVEY OF
THE W½ OF LOT 11333 AND
ALL OF LOTS 11334, 11335,
11336, AND 11337, BLOCK 204
OF LAKE COMO BEACH,
SEC 29, T2N, R17E WAL.Co. WIS.
JUNE 1964
Lloyd L Jensen
Co. SURVEYOR

